


DATE 6/2018

TOWN OF LEXINGTON — BOARD OF PUBLIC WORKS
SEWER DIVISION

Sketch of Service Here

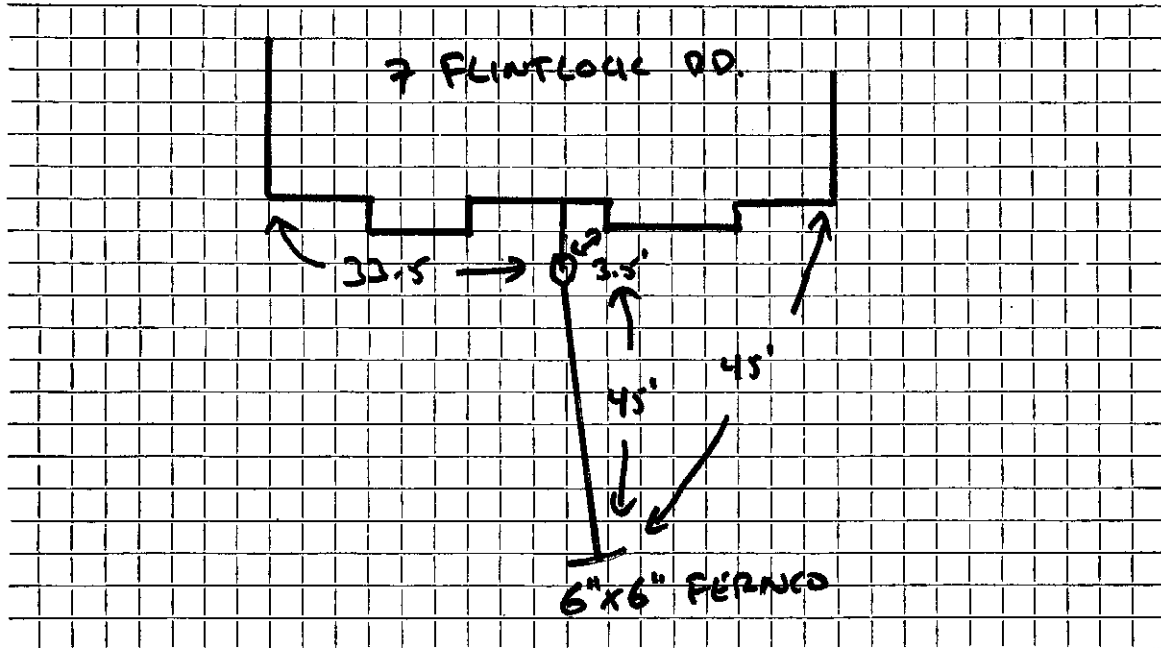

Connection made in FLINTLOCK Street. Work completed Jim McLaughlin

Remarks:
.....
.....