

Name

Service No.

Address 16 Flintlock Road

Location

Kind of Pipe

Size

Size of Main

Repair—Renewal—New Service

Location

Date

Material

Amount

Total

Date

Amount

3-11-99 Blocked grease + roots 12'

4-20 89 Blockage IN ST. 10'-15' FROM MH

USE MYRES JW-CT


4-18-98 " " CT GG J.M.

DATE \_\_\_\_\_

TOWN OF LEXINGTON — BOARD OF PUBLIC WORKS

SEWER DIVISION

Sketch of Service Here

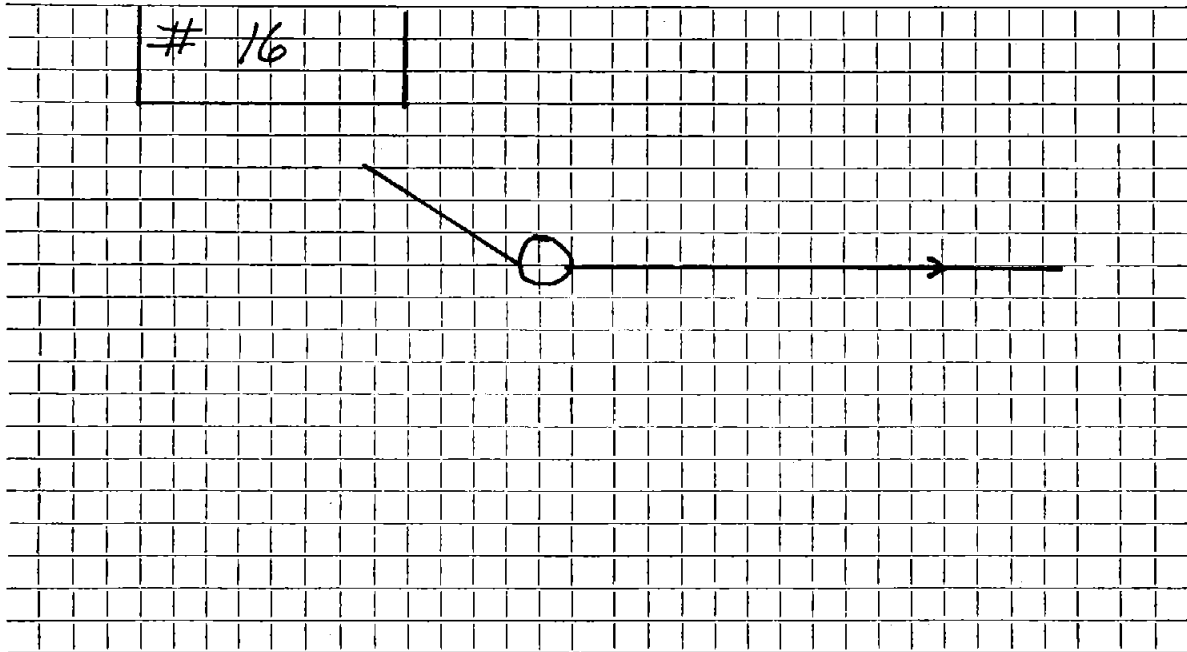

Connection made in ..... Street. Work completed .....

Remarks: SERVICE COMPS INTO M.H. Flush from M.H.