

Name J. M. Fletcher

Service No. 62

Address 22 Flintlock Road

Location

Kind of Pipe

Size

Size of Main

Repair—Renewal—**New Service** Lexington Sewerage Permit #A296


Location JUL 25 1966

Date	Material	Amount	Total	Date	Amount
<del>965</del>	<del>25' 6" Transite pipe @6.00</del>		150.00	<del>5-16-66</del>	150.00
<del>125/66</del>	<del>51' 6" Transite pipe</del>				
1/14/64	60' 6 PVC			1965	
	10' 4 PVC			25' 6" Transite	
	2 220 Brd				
	1 4x6 Fencd				
	1 6x6 Fencd PVC-AC				
	1 6x6 Fencd				

TOWN OF LEXINGTON — BOARD OF PUBLIC WORKS

SEWER DIVISION

Sketch of Service Here **22**

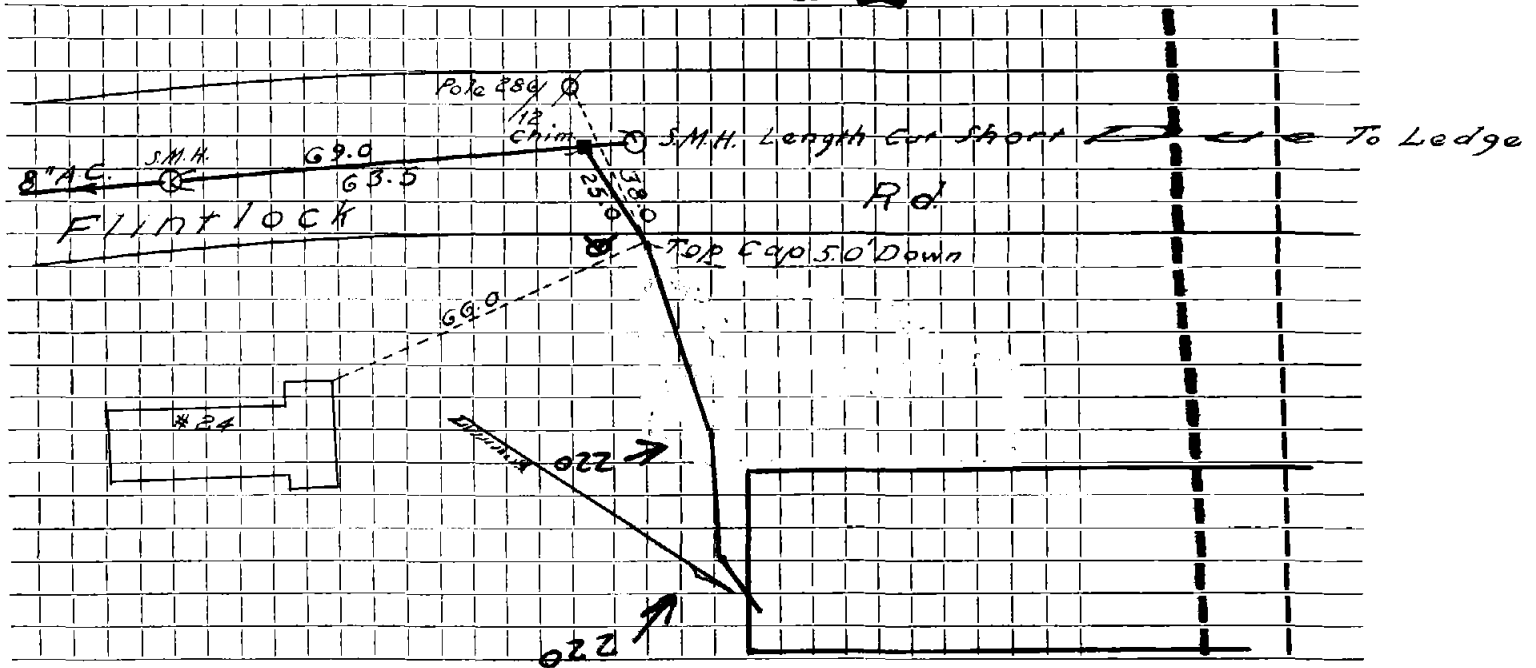

Connection made in \_\_\_\_\_ Street. Work completed \_\_\_\_\_

Remarks: *4' from hydrant*

.....  
.....  
.....