

Name **Donald Mac Kay**

Service No. 17

Address **23 Flintlock Road**

Location

Kind of Pipe

Size

Size of Main

Repair—Renewal—New Service Valeri #1563


Location **JUL 27 1970**

Date		Material	Amount	Total	Date	Amount
1965	251	6" Transite pipe @6.00		150.00	4-27-70	Deposit 150.00
4-30-70	123	6" Transite Pipe				
	10	4" Cast Iron pipe			1965	
					25' 6" Transite	

DATE _____

TOWN OF LEXINGTON — BOARD OF PUBLIC WORKS

SEWER DIVISION

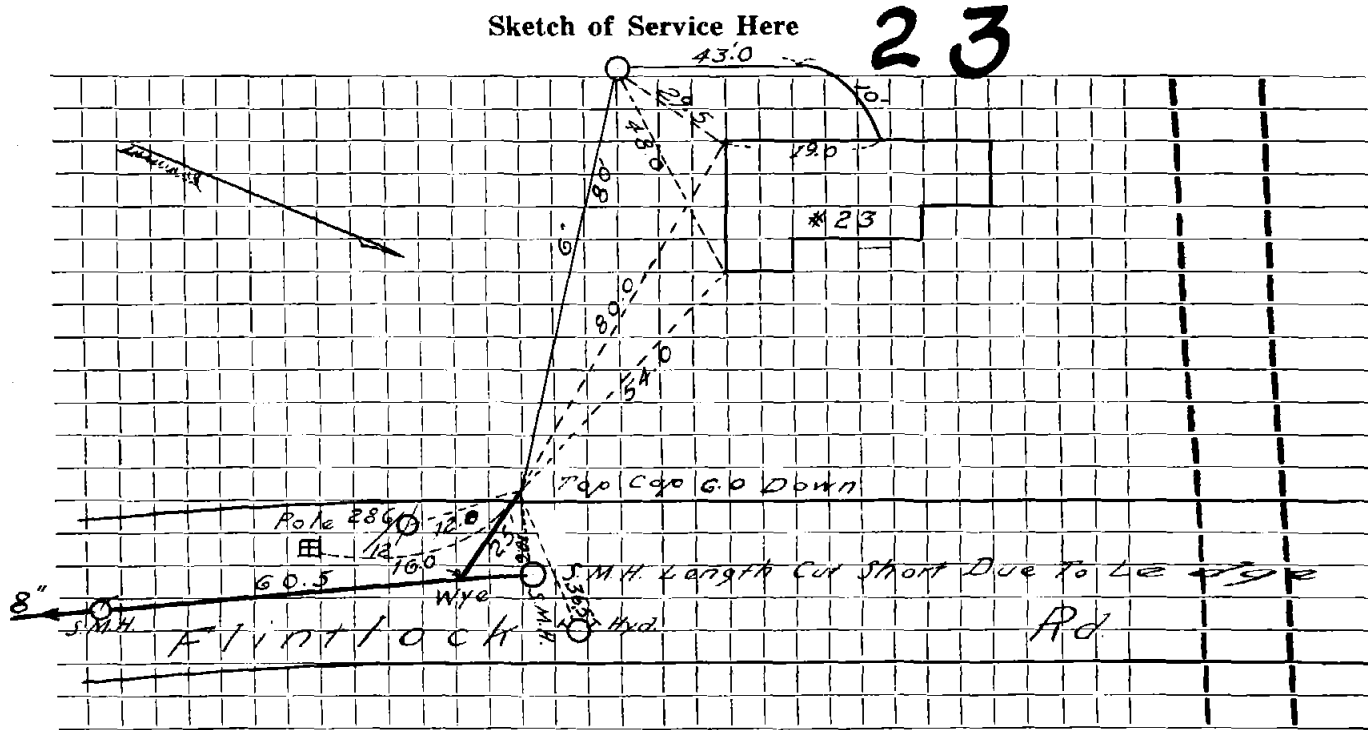

Connection made in Street. Work completed

Remarks:
.....
.....