

Name Paul McNamara

Service No. 4

Address 26 Flintlock Road

Location

Kind of Pipe

Size

Size of Main

Repair—Renewal—New Service DeFlice #1308

Location MAY 27 1969

Date		Material	Amount	Total	Date	Amount
1965	21	6" Transite pipe @6.00		126 00	3-27-69	126 00
5-8-69	44'	6" Transite pipe				
	57'	4" Cast Iron pipe			1965	
					21' 6" Transite	


DATE _____

TOWN OF LEXINGTON — BOARD OF PUBLIC WORKS

SEWER DIVISION

Sketch of Service Here

26

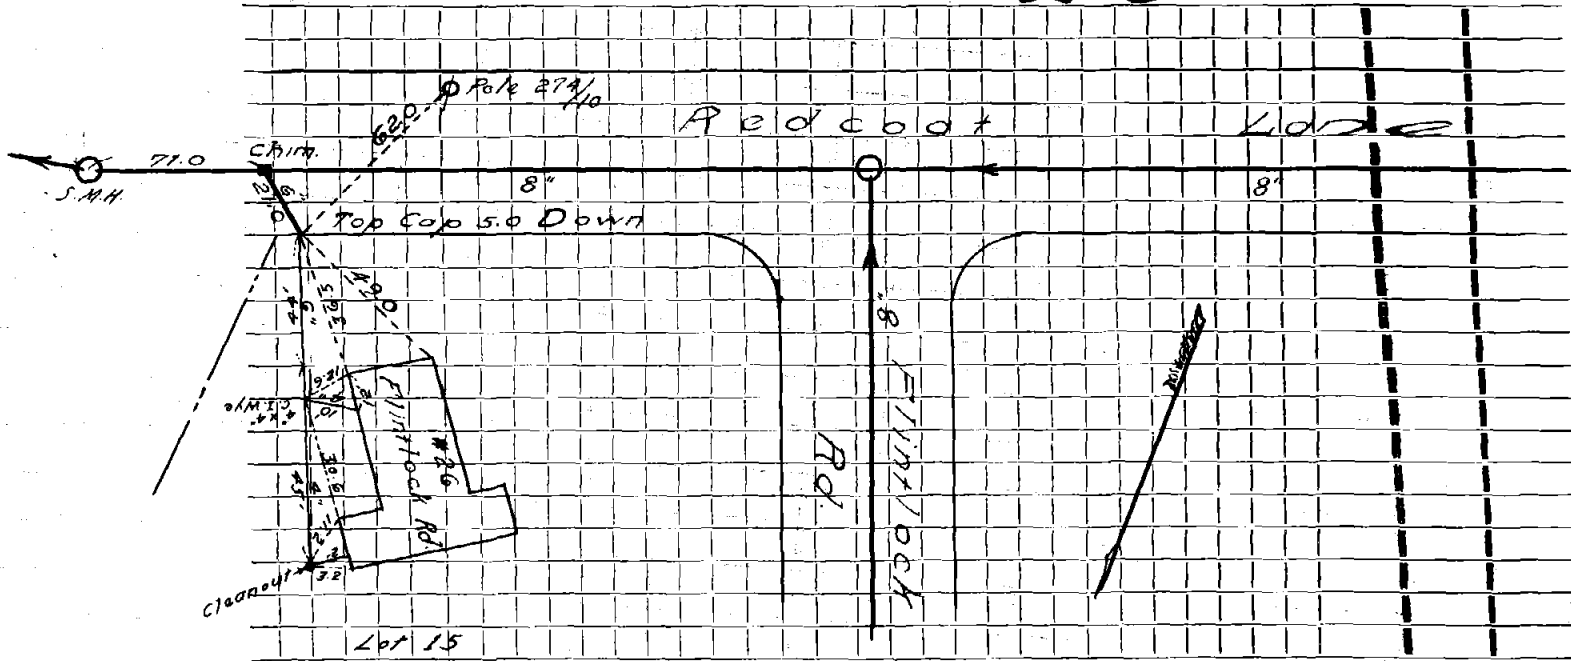

Connection made in _____ Street. Work completed _____

Remarks: _____
