

Name John F. Dowd

Service No. 240

Address 27 Flintlock Road

Location

Kind of Pipe ~~Suburban~~ banite Cesspool Permit #A119

Size of Main

~~Repair/Replace~~ **New Service**

Location MAY 2 1965

| Date | Material | Amount | Total | Date | Amount |
|---------|----------------------------|--------|-------|-----------------|--------|
| 1965 | 13' 6" Transite pipe @6.00 | | 78.00 | 11/23/65 | 78.00 |
| 1/26/65 | 61' 6" Transite pipe | | | | |
| | | | | 1965 | |
| | | | | 13' 6" Transite | |

Deposit


DATE _____

TOWN OF LEXINGTON — BOARD OF PUBLIC WORKS

SEWER DIVISION

Sketch of Service Here

27

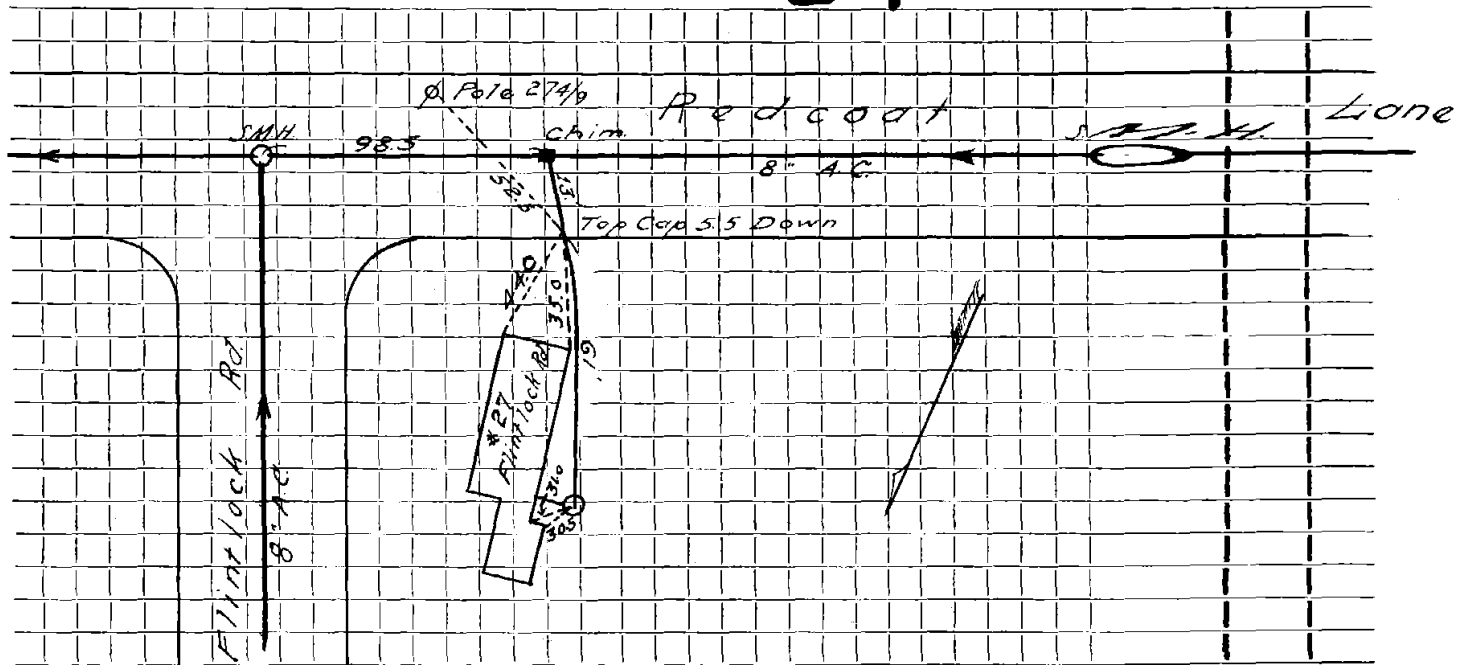

Connection made in Street. Work completed

Remarks:

.....

.....