

Name

Service No.

Address

3 Flintlock Road

Location

Kind of Pipe

Size

Size of Main

~~Repair~~ ~~Renewal~~

New Service

Location

Date

Material

Amount

Total

Date

Amount

Dec. 1953

88 - INSTALLED BY DEVELOPER

5.2.00

Repair made

22 - 6" PVC

2 - 6" x 6" PVC to Clay FRENCOS

Labor

1-18-71

11-1-74

Plugged Sewer

11 11

Plumber says 90'

Respond + Mansuet

5.2.00

Repair made

TOWN OF LEXINGTON—DEPT. OF PUBLIC WORKS  
SEWER DIVISION

DATE .....

NO. ....


The undersigned applies for the construction of a particular sewer connecting No. ....  
Street and hereby agrees to comply with the Rules and Regulations governing the construction **and** use of Particular  
Sewers, as now or at any future time established by the Board of Selectmen.

Am't of estimate \$. ....

Am't Paid \$. ....

..... Owner

Sketch of Service Here

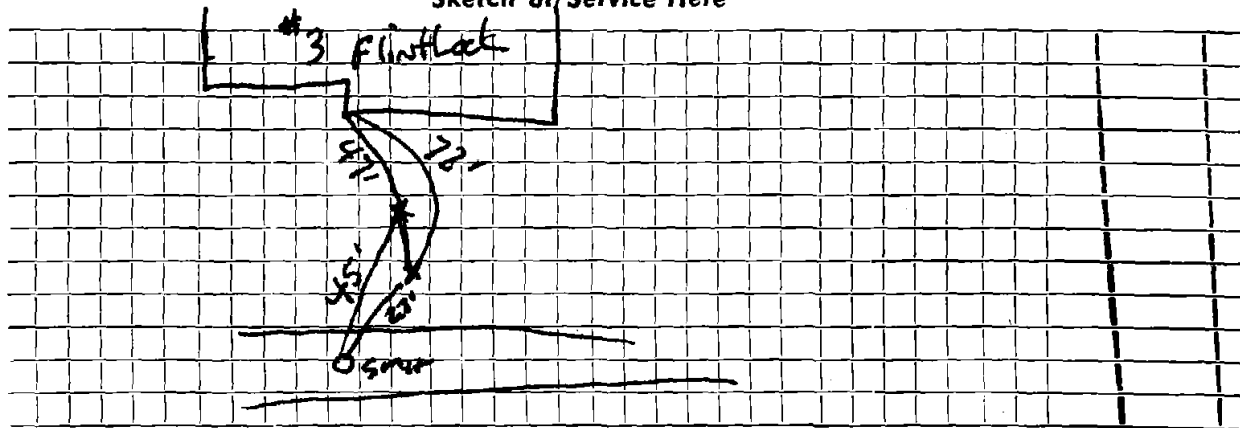

Connection made in ... *Repair made* ... Street.

Work completed .. - - - - - 19..

Remarks: *ON property*