


DATE 6/8/2022

TOWN OF LEXINGTON — BOARD OF PUBLIC WORKS

SEWER DIVISION

Sketch of Service Here

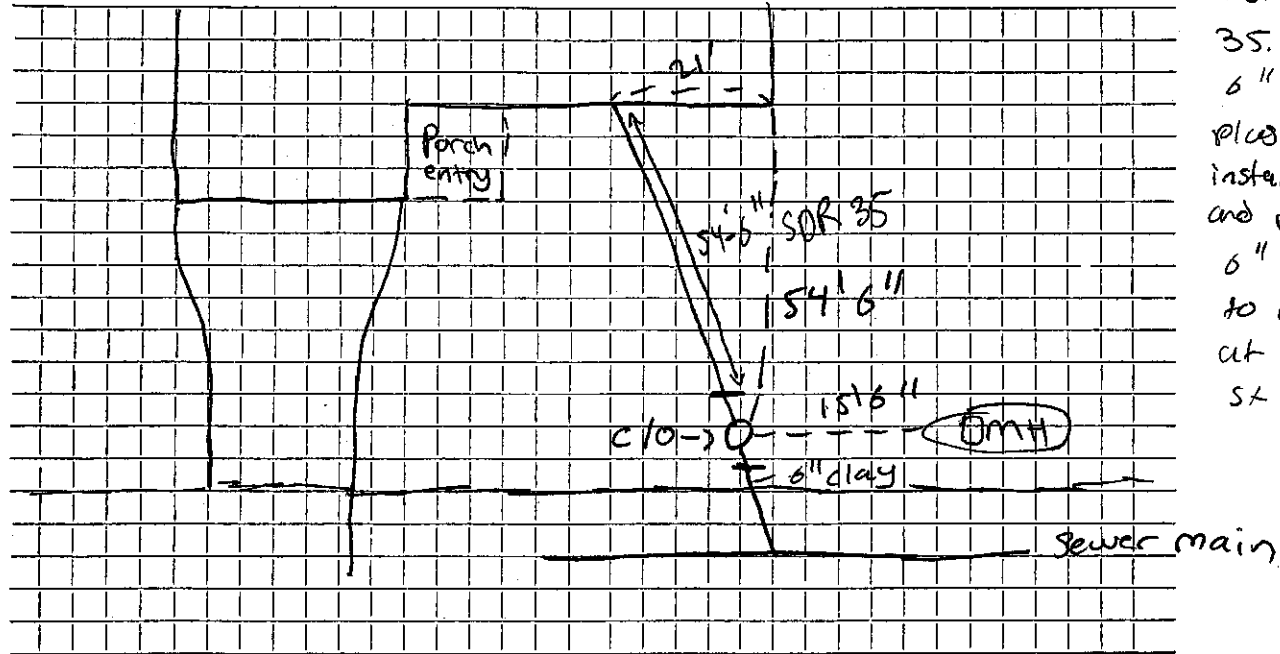

Reset Pitch on
 existing 6" SOR
 35. Removed
 6" clay to
 plastic Fernco
 installed C/O
 and reattached
 6" plastic
 to 6" clay
 at edge of
 st w Fernco

Connection made in ... S. Flintlock Rd ... Street.

Work completed

Remarks: ... Rowseil Boss