




DATE 5/16/2000

TOWN OF LEXINGTON — BOARD OF PUBLIC WORKS  
SEWER DIVISION

Sketch of Service Here

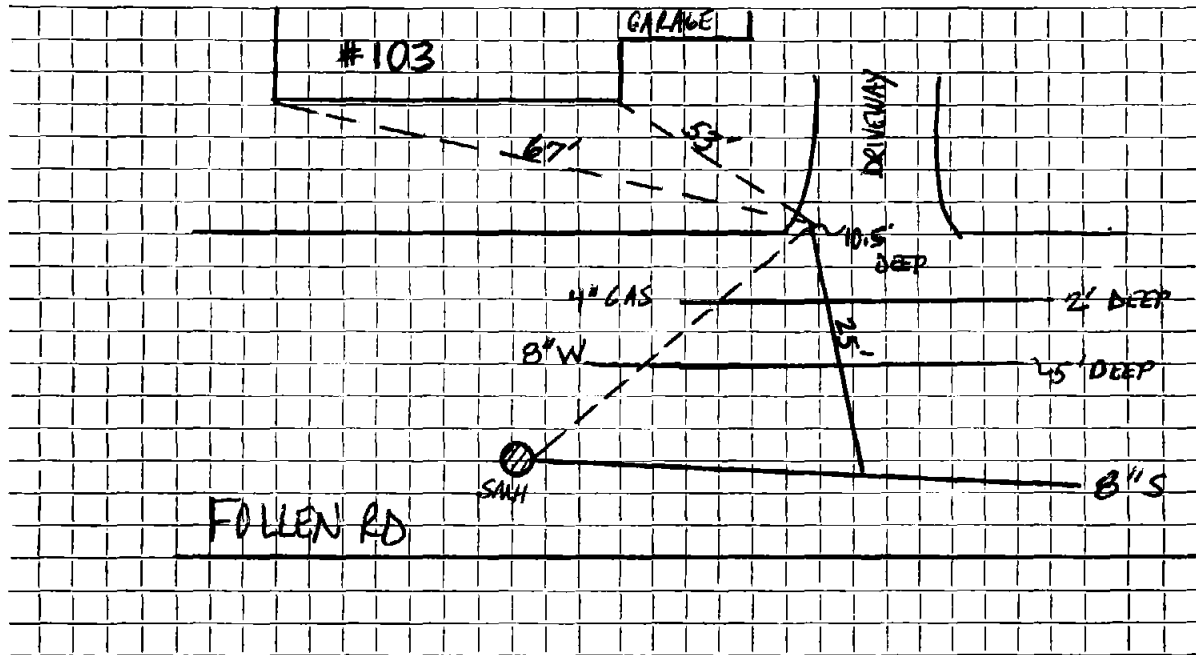

Connection made in FOLLEN RD. Street. Work completed .....

Remarks: 25' OF 6" PVC INSTALLED .....

SERVICE ~ 10.5' DOWN FROM PAYEMENT .....

\* GAS MAIN ~ 2' FROM END OF SEWER SERVICE .....

FIELD BOOK 99-12-2, PG. 41.

D.F.