

Name

Service No.

Address

104 FOLLEN RD

Location

Kind of Pipe

Size

Size of Main

Repair—Renewal—New Service

Location

Date

Material

Amount

Total

Date

Amount


9-25-51

102' 6" Sewer Pipe

3-26-81 Solids

DATE \_\_\_\_\_

TOWN OF LEXINGTON — BOARD OF PUBLIC WORKS  
SEWER DIVISION

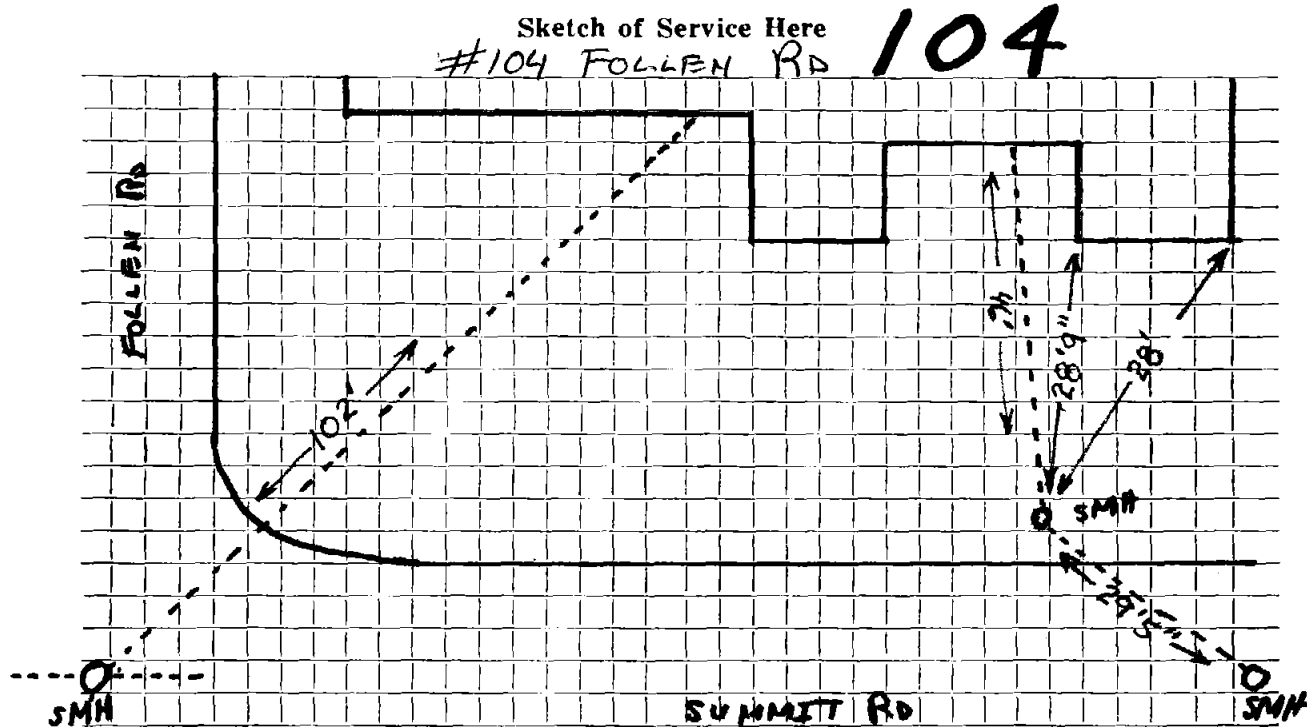

Connection made in ..... Street. Work completed .....

Remarks: Two 6" CHAY SERVICES FOR THIS HOUSE ORIGINAL SERVICE 9-2-47