

Name Robert J. Kelley  
 Address 109 Follen Road

Service No. 5 241

Location

Kind of Pipe

Size

Size of Main

~~Repair~~ ~~Renewal~~ New Service

Location

Date	Material	Amount	Total	Date	Amount
------	----------	--------	-------	------	--------

P. 4-14-31 for 75.	57' 6" Sewer Pipe @ .25	14 25		March 27, 1931 - Cash	75 -
	Sulphur & Jute	2 28			
	Trucking	<u>2 00</u>	18 53		

4/9/31	88 Hrs. Labor @ .55	48 40			
	15% Overhead	<u>7 26</u>	55 66		

Aug. 10	Refund		74 19		
			FL		
			75-00		

Labor

9/29/68

Roots

Hadley Press, Inc., Lexington

TOWN OF LEXINGTON—BOARD OF PUBLIC WORKS

SEWER DIVISION

DATE March 24, 1931

NO. 109 Follow Rd


The undersigned applies for the construction of a particular sewer connecting No. 109 Follow Rd Street and hereby agrees to comply with the Rules and Regulations governing the construction and use of Particular Sewers, as now or at any future time established by the Board of Selectmen.

Am't. of Estimate \$ \_\_\_\_\_

Am't. Paid \$ \_\_\_\_\_

Robert J. Kelley Owner

Sketch of Service Here

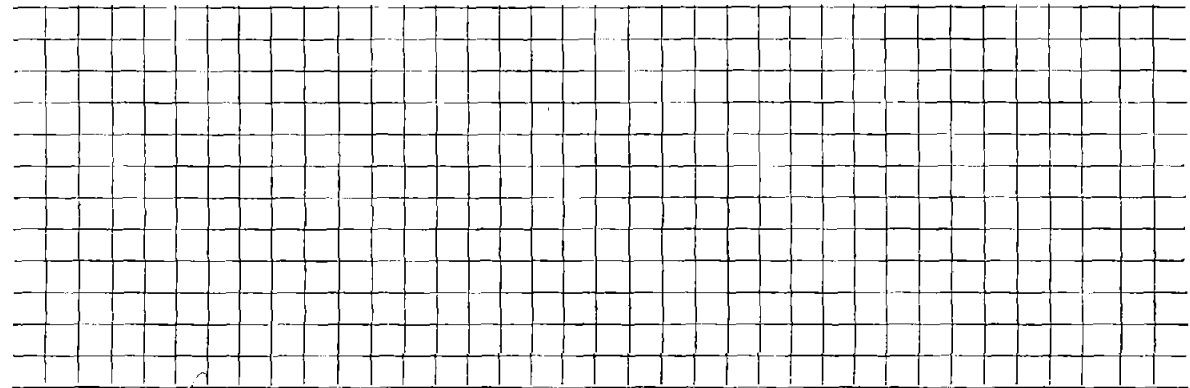

Est'd  
March 30

Connection made in Smith Ave. Street. Work completed \_\_\_\_\_ 19

Remarks: Connection with Smith Ave