

Name John McAleer

Service No. 42

Address 121 Follen Road

Location

Kind of Pipe

Size

Size of Main

~~Repair Renewal New Service~~

*Dave Eagle #2061*  
W. O. # 8582

Location JUN 5 1972

Date	Material	Amount	Total	Date	Amount
4/19/72	Labor	84 04		4-14-72	310 00
5/15/72	"	33 26		6-5-72	11 17
	10% O.H.	11 73	129 03		198 83
	27' 6" Transite pipe .90		24 30		
	2 6" Couplings 1.78		3 56		
	1 6" Plug		2 38		
	1 90o Elbow		5 65		
	1/2 Bag cement 1.95		98		
	2 Dozen brick .07 ea.		1 68		
	1 1/2 Ton Cold patch 8.00		12 00		
	3 Hrs. Trucking 3.00		9 00		
	1 1/2 Hrs. " 1.50		2 25		
	1 Hr. Compressor		5 00		
	1/2 " Roller 2.00		1 00		
	Trailer		2 00		
			198 83		

DATE \_\_\_\_\_


TOWN OF LEXINGTON — BOARD OF PUBLIC WORKS

SEWER DIVISION

121

Sketch of Service Here

Ho. # 121 Follen Rd.

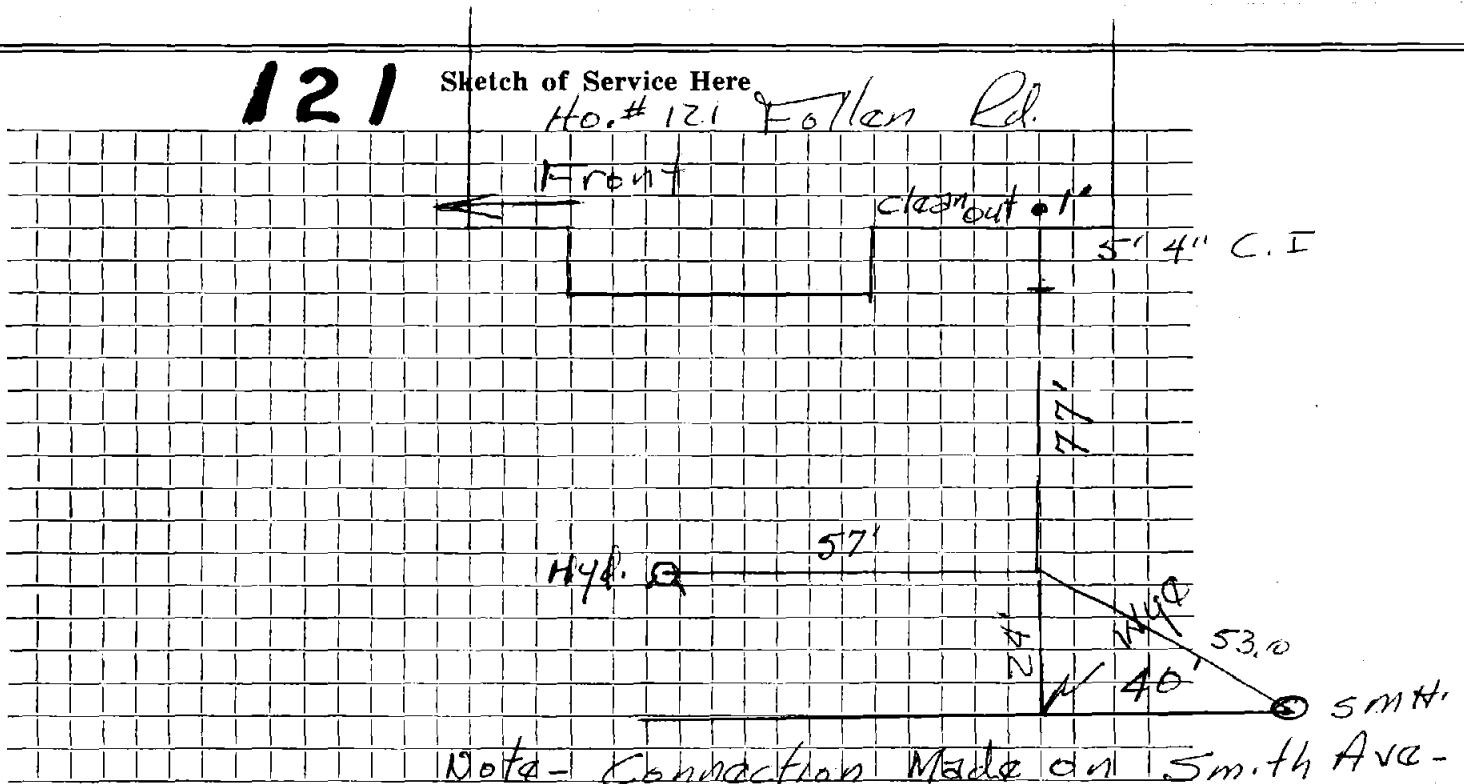

Note - Connection Made on Smith Ave -

Connection made in ..... Street. Work completed .....

Remarks: .....

.....  
.....