

Name James P. Stone

Service No. 136

Address 142 Follen Road

Location

Kind of Pipe

Size

Size of Main

Repair—Renewal—New Service

Location MAR 23 1964

W.P.# 8242


Date		Material	Amount		Total		Date		Amount	
11/6/63		Labor	80	26			4-14-63	Deposit	300	00
11/7/63		Labor	24	48			2-17-65	Paid	158	08
11/8/63		Labor	41	58					358	08
11/14/63		Labor	37	04						
			183	36						
		10% Overhead	18	34	201	70				
	83'	6" Transite pipe @ .82			68	06				
	1	90° Transite elbow			4	09				
	2	1 1/4° Transite Bends @ 4.09			8	18				
	1	6" Duplex Adapter			1	35				
	2	22 1/2° Transite Elbows @ 2.35			4	70				
	8	yds. Loam @ 3.00			24	00				
	16	x 3 Patch			16	00				
	4	hrs. Town Shovel @ 3.00			12	00				
	6	hrs. Trucking @ 3.00			18	00				
					358	08				

DATE _____

TOWN OF LEXINGTON — BOARD OF PUBLIC WORKS

SEWER DIVISION

Sketch of Service Here

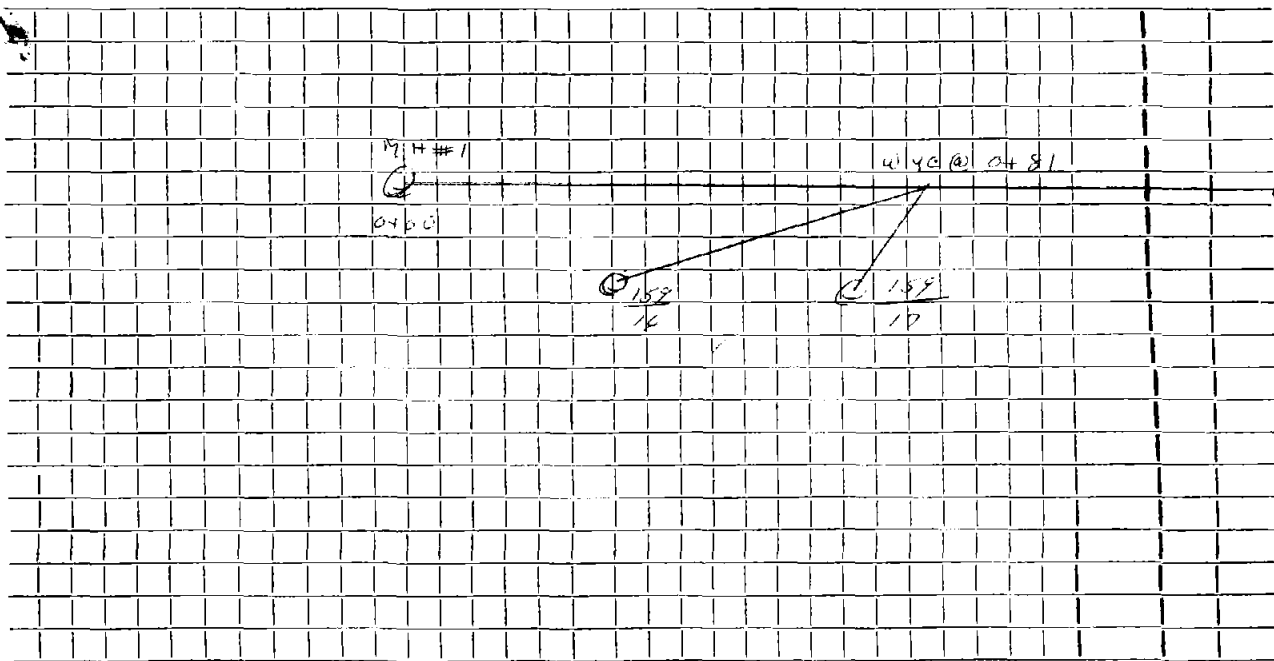

Connection made in Street. Work completed

Remarks:
.....
.....