

Name J. B. Rankin

Service No. 59

Address 143 Follen Rd.

Location

Kind of Pipe

Size

Size of Main

Repair—Renewal—New Service

WO# 7997

Location

Comm 10-28-63

Date	Material	Amount	Total	Date	Amount
6/10/63	Labor	64 60		5-31-63	Deposit 250 00
6/11/63	Labor	49 93		12-27-63	Paid 2 51
		114 53			252 51
	10% Overhead	11 45	125 98		
67'	6" Transite Pipe @ .82		54 94		
1	22½° Transite Bend		4 09		
5	hrs. Town Shovel @ 6.50		32 50		
4	hrs. Trucking @ 3.00		12 00		
	14x3 Patch		14 00		
3	yds. Loam @ 3.00		9 00		
			252 51		
	Labor				

TOWN OF LEXINGTON—DEPT. OF PUBLIC WORKS

SEWER DIVISION

DATE

NO.

The undersigned applies for the construction of a particular sewer connecting No.
Street and hereby agrees to comply with the Rules and Regulations governing the construction and use of Particular
Sewers, as now or at any future time established by the Board of Selectmen.


Am't of estimate \$.....

Am't Paid \$.....

..... Owner

Sketch of Service Here

143

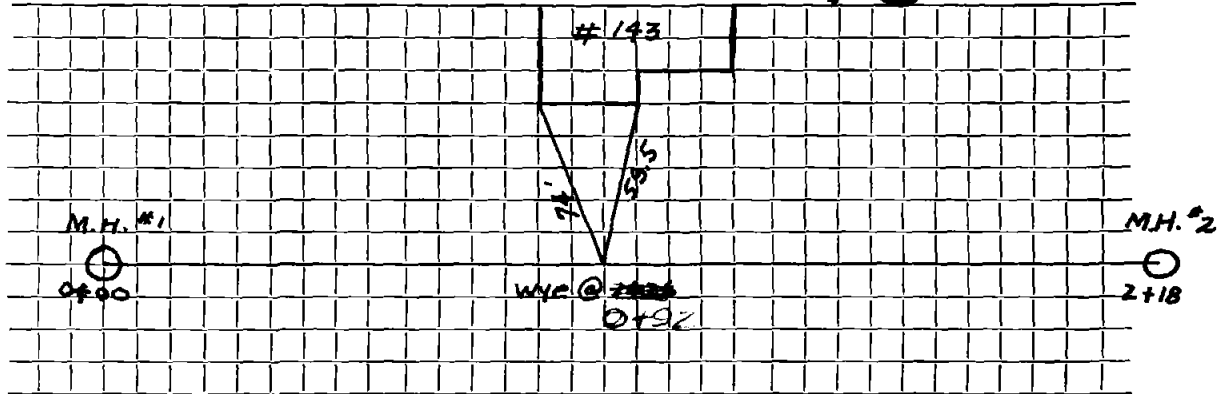

Connection made in Street.

Work completed 19..

Remarks: