


DATE 9-7-94

TOWN OF LEXINGTON — BOARD OF PUBLIC WORKS
SEWER DIVISION

Sketch of Service Here

16

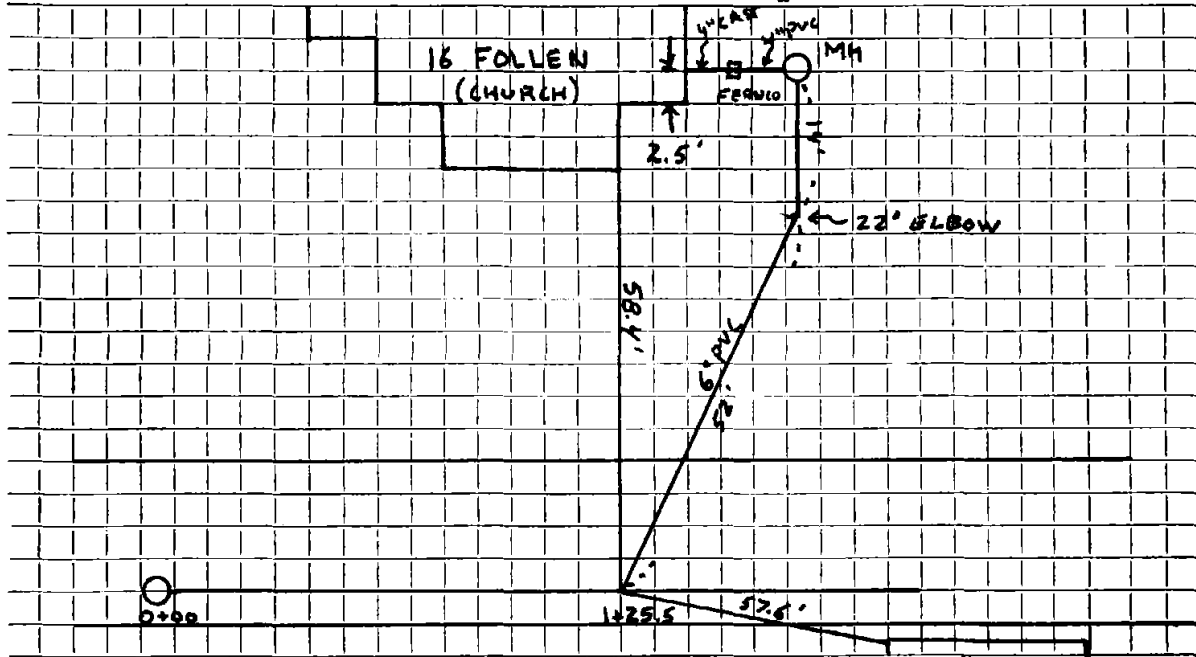

Connection made in FOLLEN ROAD Street. Work completed #21 FOLLEN

Remarks:

.....

.....