

Name

Service No.

Address 162 Follen Road

west OF #152

Location

Kind of Pipe

Size

Size of Main

Repair—Renewal New Service


Location

Date	Material	Amount	Total	Date		Amount
Sept. 05 - 27	6" Transite pipe @ \$5.00		135.00			
				9- - 65		
				27' 6" Transite		

DATE _____

TOWN OF LEXINGTON — BOARD OF PUBLIC WORKS
SEWER DIVISION

Sketch of Service Here

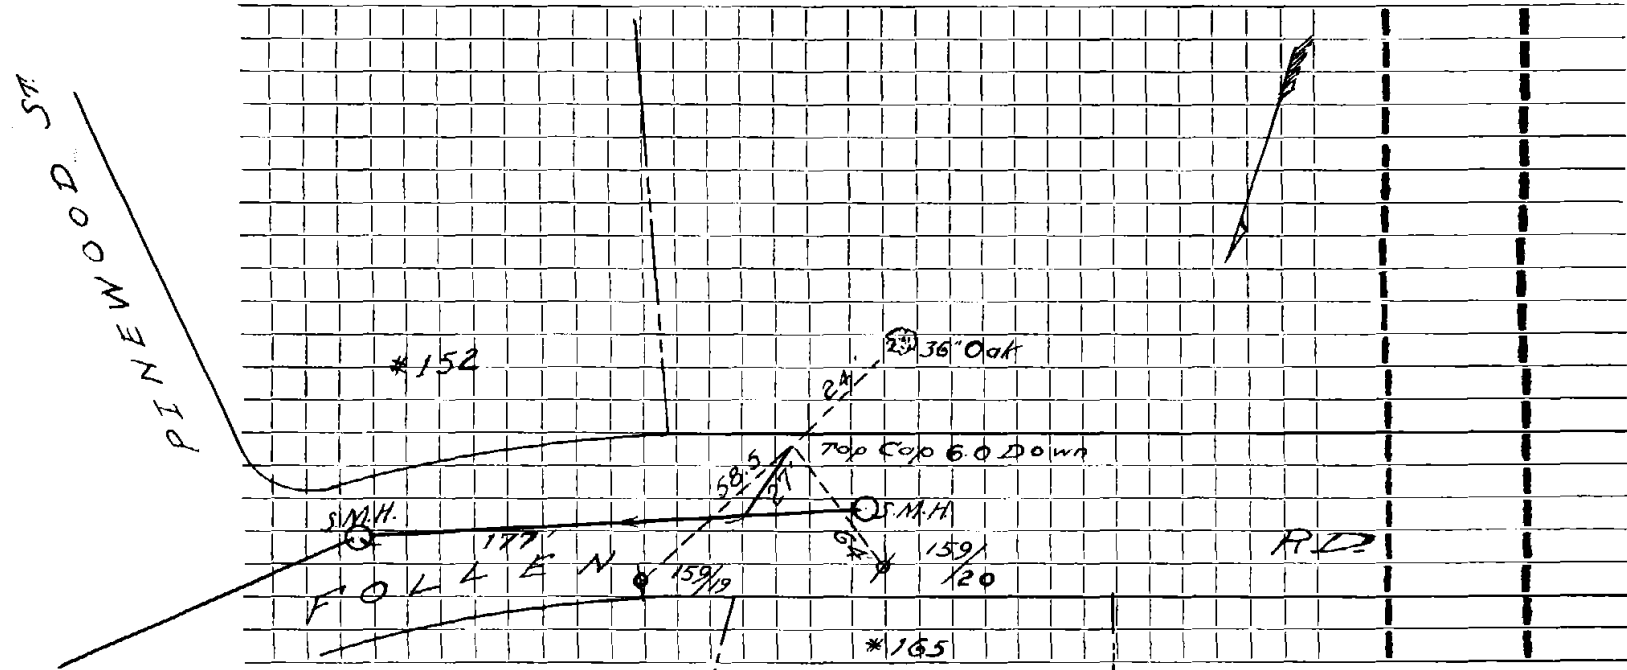

Connection made in Street. Work completed

Remarks:
.....
.....