

Name Richard McGann

Service No. 155 (165)

Address 16.5 Fallen Rd

Location

Kind of Pipe

Size

Size of Main


~~Repair/Renewal~~ **New Service** Valeri Const. Permit #447

Location JUN 23 1966

Date	Material	Amount	Total	Date	Amount
Sept. '65 25'	<del>6" Transite pipe @5.00</del>		125.00	9-8-65	125 00
-16-65 83'	6" Transite pipe			9- - 65	
				25' 6" Transite	

DATE \_\_\_\_\_

TOWN OF LEXINGTON — BOARD OF PUBLIC WORKS  
SEWER DIVISION

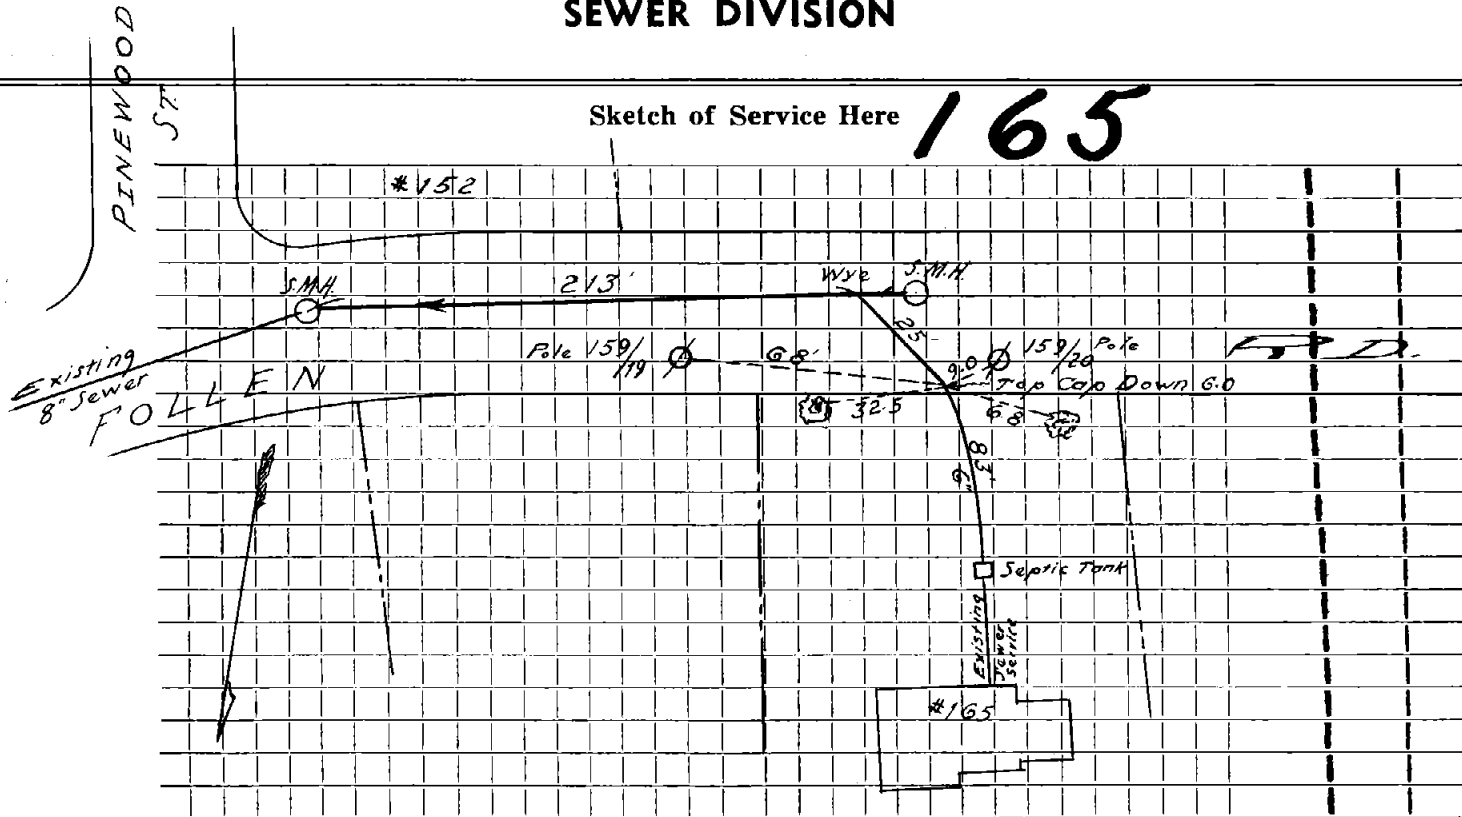

Connection made in ..... Street. Work completed .....

Remarks: .....

.....

.....