


DATE 6-5-95

TOWN OF LEXINGTON — BOARD OF PUBLIC WORKS
SEWER DIVISION

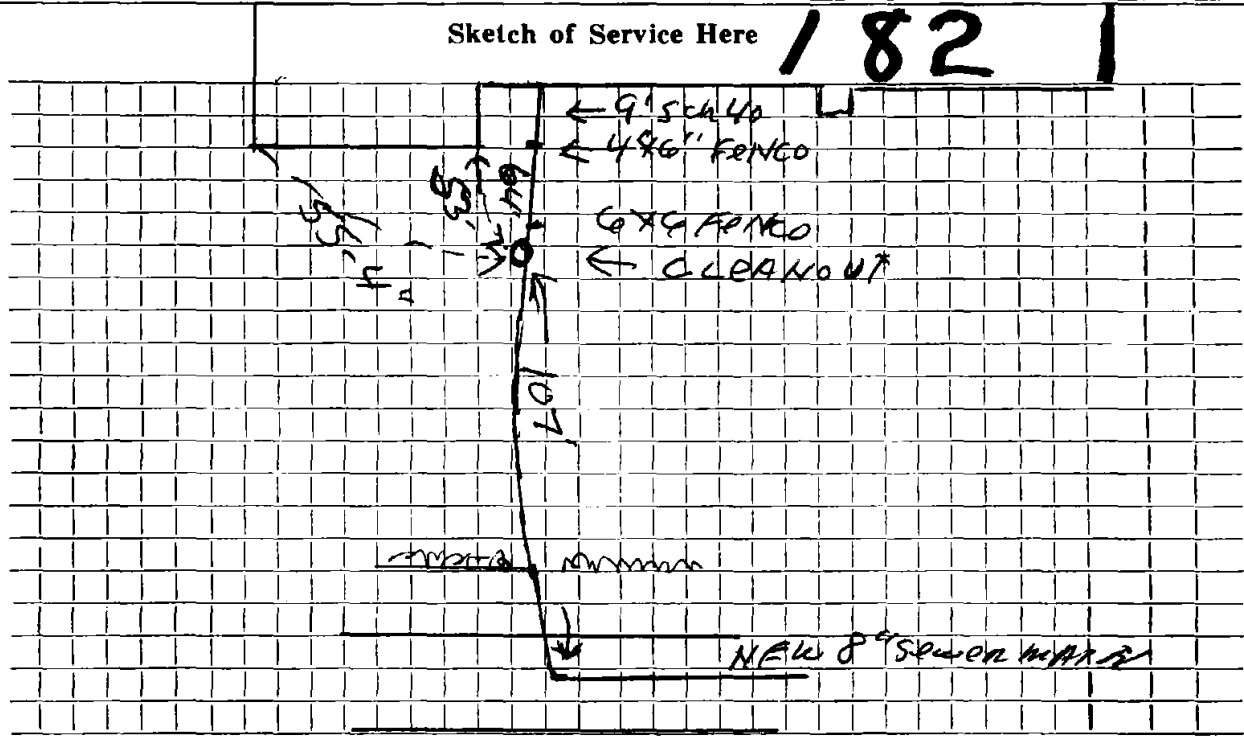

Connection made in ... 6-5-95 Street. Work completed ... 6-5-95

Remarks:
.....
..... **BRUCE J. MCKEE**