

Name G.H. Conant

Service No. 84

Address 201 Follen Road

Location

Comm. 10-8-56

Kind of Pipe

Size

Size of Main

~~Repair~~ ~~Renews~~ ~~█~~ New Service

Location


Date	Material	Amount	Total	Date	Amount	
1/56	Labor	45 07		7-6-56	Deposit	250 00
	10% Overhead	4 51	49 58	10-8-56	Revised	11 43
	62' 6" Sewer Pipe @ .455		28 21			118 65
	joint compound		3 72			
	1 6" 1/4 bend		1 88			
	8 2/3 hrs. Littlefield @ 8.50		73 66			
	2 hrs. trucking @ .75		1 50			
			158 55			
	Labor					

DATE _____

TOWN OF LEXINGTON — BOARD OF PUBLIC WORKS

SEWER DIVISION

Sketch of Service Here **203**

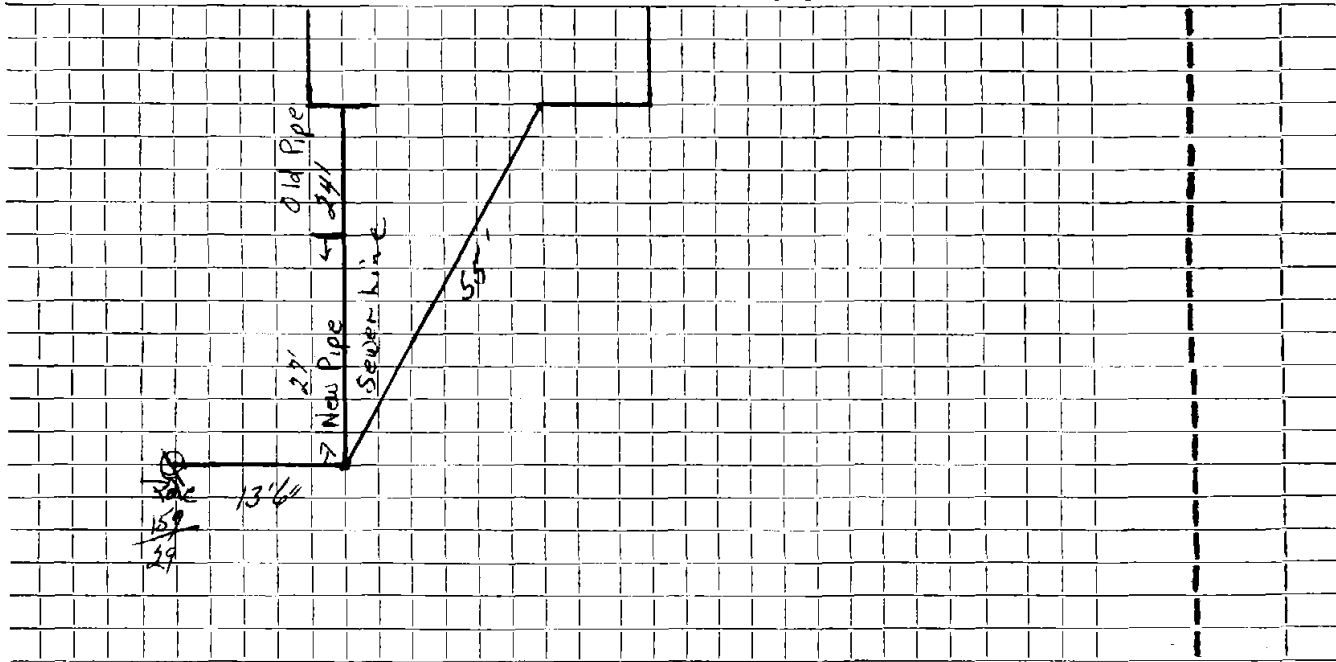

Connection made in Street. Work completed

Remarks:
.....
.....

Name G.H.Conant

Service No. 84

Address 201 Follen Road

Location

Comm. 10-8-56

Kind of Pipe

Size

Size of Main

~~Repair~~ ~~Renewal~~ — New Service

Location

Date	Material	Amount	Total	Date	Amount
8/1/56	Labor	45 07		7-6-56	<i>deposit</i> 250 00
	10% Overhead	4 51	49 58	10-8-56	<i>Refund</i> 11 43
	62' 6" Sewer Pipe @ .455		28 21		
	joint compound		3 72		
	1 6" $\frac{1}{4}$ bend		1 88		
	8 $\frac{2}{3}$ hrs. Littlefield @ 8.50		73 66		
	2 hrs. trucking @ .75		1 50		
			158 55		
	Labor				

TOWN OF LEXINGTON—DEPT. OF PUBLIC WORKS
SEWER DIVISION

DATE.....

NO.


The undersigned applies for the construction of a particular sewer connecting No.....
Street and hereby agrees to comply with the Rules and Regulations governing the construction and use of Particular
Sewers, as now or at any future time established by the Board of Selectmen.

Am't of estimate \$.....

Am't Paid \$.....

..... Owner

Sketch of Service Here

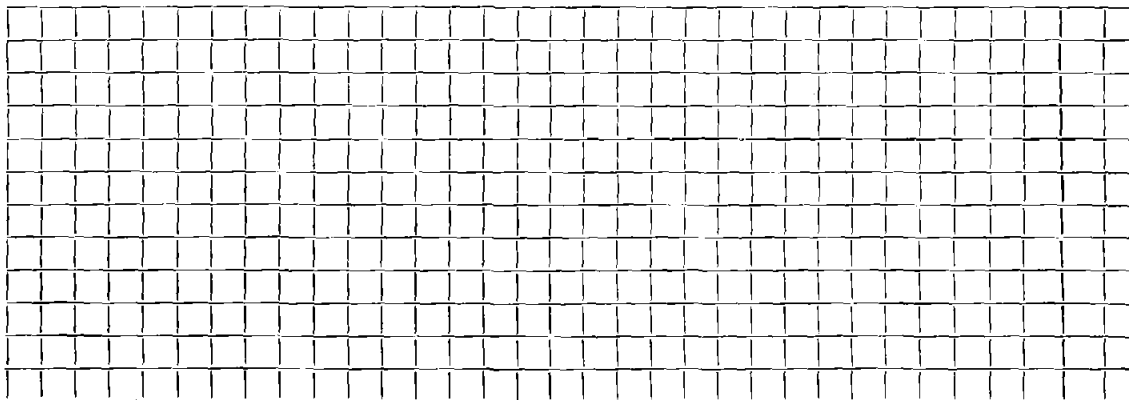

Connection made in..... Street.

Work completed..... 19..

Remarks: