

Name Alfred J. Parece

Service No. 170 (1954)

Address 204 Follen Road

Location

Kind of Pipe

Size

Size of Main

~~Repair~~ ~~Renewal~~ New Service

COM. 4-11-55

Location

Date	Material	Amount	Total	Date	Amount
3/3/55	Labor	71 50		12-21-54	Deposited 175 00
	10% overhead	7 15	78 65	4-11-55	Refunded (137)
	70' - 6" sewer pipe @ .32		22 40		NON CHARGE 173 63
	1 - 6" elbow		1 88		Patching 5 x 3 5 00
	joint compound		4 20		
	6 hrs. Littlefield shovel @ 7.50		45 00		
	2 hrs. trucking @ .75		1 50		
	patching 20 x 3		20 00		
			173 63		
	<b>Labor</b>				

**TOWN OF LEXINGTON—DEPT. OF PUBLIC WORKS**  
**SEWER DIVISION**

DATE.....

NO. ....

The undersigned applies for the construction of a particular sewer connecting No.....  
Street and hereby agrees to comply with the Rules and Regulations governing the construction and use of Particular  
Sewers, as now or at any future time established by the Board of Selectmen.


Am't of estimate \$.....

Am't Paid \$.....

..... Owner

---

**Sketch of Service Here**

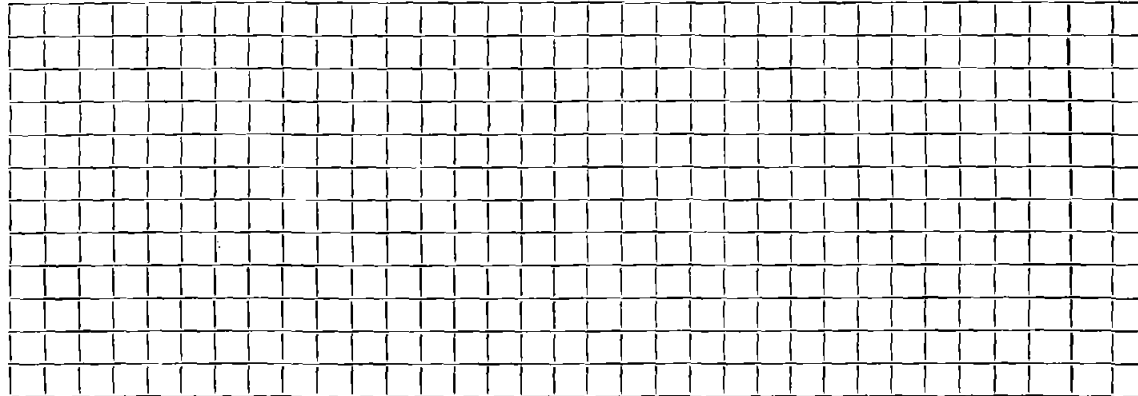

Connection made in..... Street.

Work completed.....19..

Remarks: