

Name Scott Fisher

Service No.

Address 205 Follen Road

Location

Kind of Pipe

Size

Size of Main

~~Repair~~ ~~Renewal~~ ~~---~~ ~~New~~ ~~Service~~ Eagle #3495

Location

Date	Material	Amount	Total	Date	Amount
------	----------	--------	-------	------	--------

6/23/80	45' 6" Transite pipe				
---------	----------------------	--	--	--	--


OUTSIDE

6/17/80	18' 6" Transite pipe 17 x 8 Patch				
---------	--------------------------------------	--	--	--	--

DATE _____

TOWN OF LEXINGTON — BOARD OF PUBLIC WORKS
SEWER DIVISION

205 Sketch of Service Here

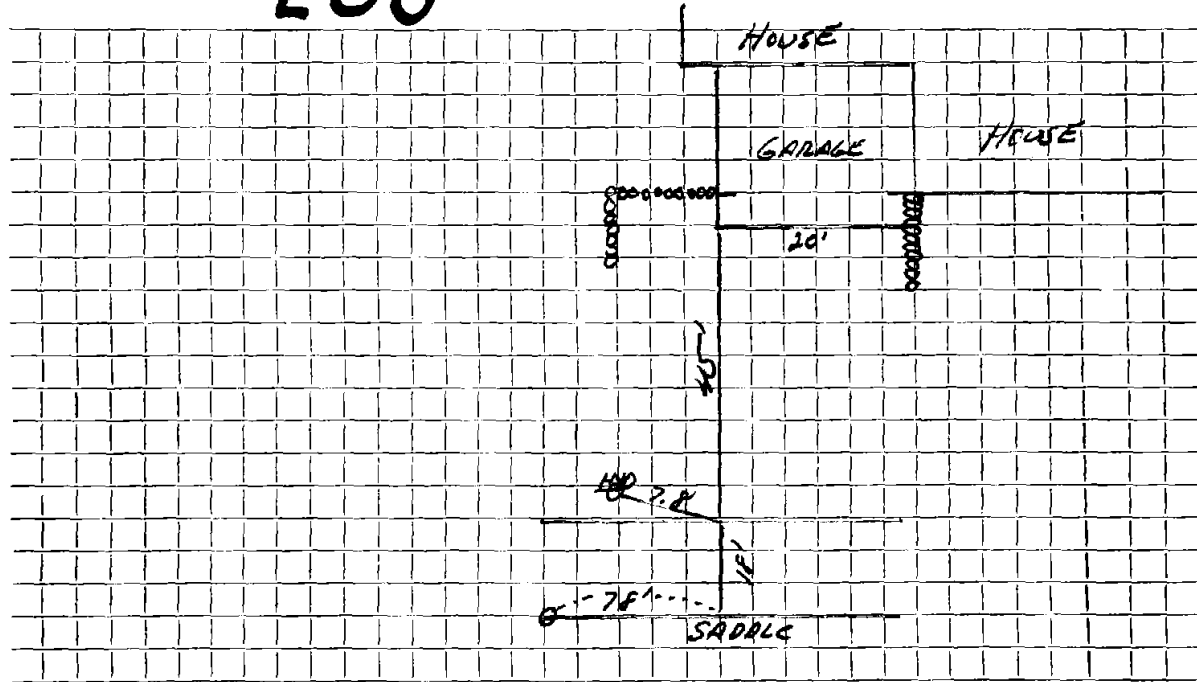

Connection made in Street. Work completed

Remarks:

.....
.....