

Name N. A. Colbert

Service No. 201

Address 206 Hollen Road

Lexington

Location

Kind of Pipe

Size

Size of Main

Repair ~~Renewal~~ — New Service

COM. 2-4-52

Location

Date	Material	Amount	Total	Date	Amount
1/14/52	Labor	49 59		12-4-51	Deposited 125 00
1/15/52	"	29 07	78 66	2-2-55	Paid 44 42
	10% overhead		7 87		169 42
	56' - 6" sewer pipe @ .342		19 15		
	1 - 6" elbow		1 88		
	joint compound		3 36		
	6 hrs. Littlefield shovel @ 7.		42 00		
	2 hrs. trucking		1 50		
	patching 15 x 3		15 00		
			169 42		

Labor

TOWN OF LEXINGTON—DEPT. OF PUBLIC WORKS

SEWER DIVISION

DATE

NO.


The undersigned applies for the construction of a particular sewer connecting No. Street and hereby agrees to comply with the Rules and Regulations governing the construction and use of Particular Sewers, as now or at any future time established by the Board of Selectmen.

Am't of estimate \$.....

Am't Paid \$.....

..... Owner

Sketch of Service Here

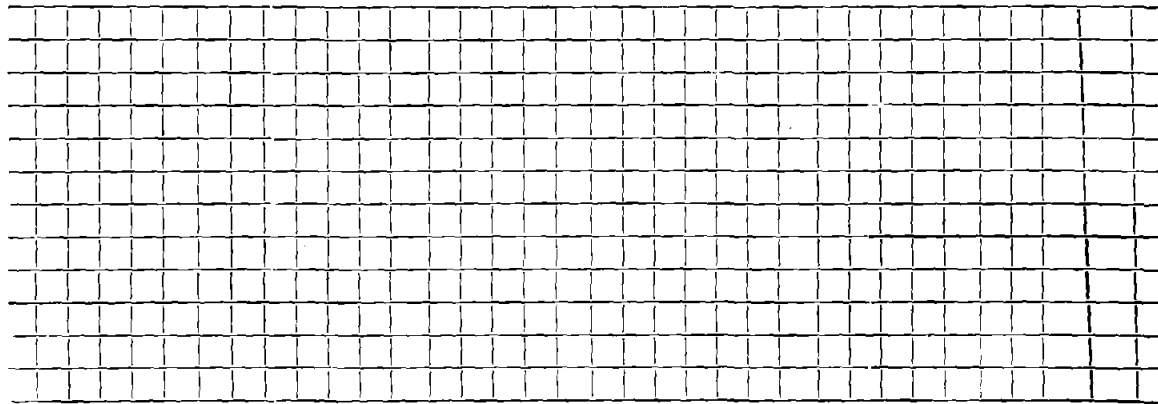

Connection made in Street.

Work completed , 19..

Remarks: