

Name **Walter J. Lyons**

Service No. 103

Address 208 Follen Road

Location

Kind of Pipe

Size

Size of Main

~~XXXXXXXXXXXX~~ — New Service W.O. #8124

Location Comm 10-25-63

Date	Material	Amount	Total	Date	Amount
8-29-63	Labor	43.12		8-19-63	300 00
9-3-63	"	87.80		11-8-63	30 68
9-4-63	"	40.52	171 44		330 68
	10% O.H.	17 14	188 58		
	55 6" Transite Pipe @ .82		45 10		
	6 hrs. Town Shovel @ 6.50		39 00		
	5 hrs. Trucking @ 3.00		15 00		
	21 x 4 Patch		28 00		
	5 yds. Loam @ 3.00		15 00		
			330 68		

Walter J. Lyons


DATE _____

TOWN OF LEXINGTON — BOARD OF PUBLIC WORKS

SEWER DIVISION

Sketch of Service Here

208

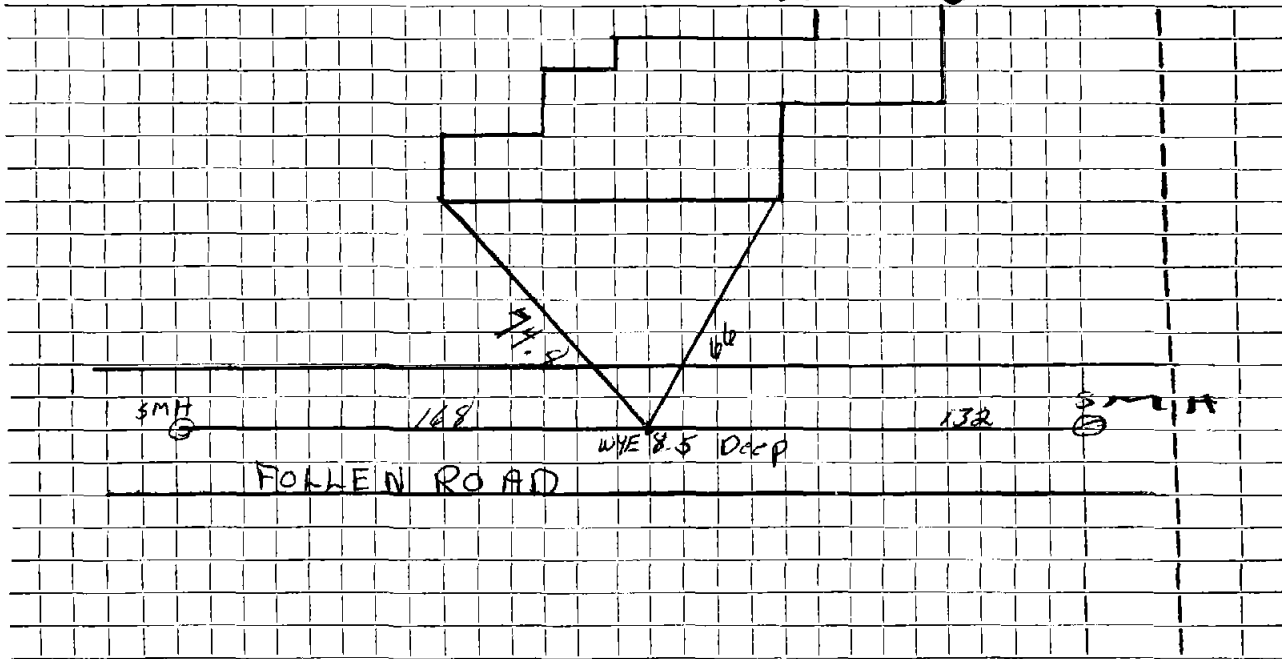

Connection made in Street. Work completed

Remarks:

.....

.....