

Name **A. J. Comeau**

Service No. **6**

Address **210 Follen Road**

Location

Kind of Pipe

Size

Size of Main

~~Repair-Renewal~~ **New Service COM. 3-22-54**

Location

| Date | Material | Amount | Total | Date | Amount |
|------|----------|--------|-------|------|--------|
|------|----------|--------|-------|------|--------|

| | | | | | |
|--------|--------------------------------------|-------|--------|---------|------------------|
| 3/2/54 | Labor | 31 92 | | 2-12-54 | Deposited 175- |
| | 10% overhead | 3 19 | 35 11 | 3-22-54 | Refunded (49 77) |
| | 60' - 6" sewer pipe @ .3087 | | 18 52 | | 125 23 |
| | joint compound | | 3 60 | | |
| | 5 2/3 hrs. Littlefield shovel @ 7.50 | | 42 50 | | |
| | 2 hrs. trucking | | 1 50 | | |
| | patching 24 x 3 | | 24 00 | | |
| | | | 125 23 | | |

Labor

TOWN OF LEXINGTON—DEPT. OF PUBLIC WORKS
SEWER DIVISION

DATE

NO.


The undersigned applies for the construction of a particular sewer connecting No.
Street and hereby agrees to comply with the Rules and Regulations governing the construction **and** use of Particular
Sewers, as now or at any future time established by the Board of Selectmen.

Am't of estimate \$.

Am't Paid \$.

..... Owner

Sketch of Service Here

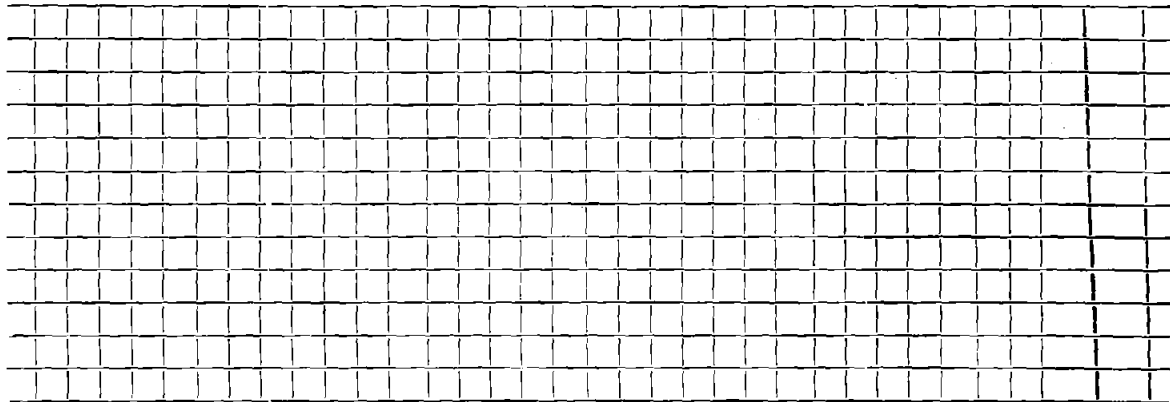

Connection made in Street.

Work completed 19..

Remarks:
