

Name Nathaniel Colbert

Service No. 50

Address 218 Follen Road

Location Lexington, Mass.

Kind of Pipe

Size

Size of Main

~~Removed~~ New Service

COM 7-24-51

Location

Date	Material	Amount	Total	Date		Amount
5-25-51	Labor	10 26	10 26	May 24 1951	Deposited	150 -
6-26-51	Labor	54 72	54 72	12-7-54	Paid	(7 37
6-27-51	Labor	18 81	18 81			157 37
	10% Overhead		8 38		" " 3-15-52	
	54'-6" Sewer Pipe @.342		18 46			
	Joint Compound		3 24			
	6 Hr. Littlefield Shovel		42 00			
	2 Hr. Trucking		1 50			
			157 37			
	Labor					

TOWN OF LEXINGTON—DEPT. OF PUBLIC WORKS
SEWER DIVISION

DATE

NO.


The undersigned applies for the construction of a particular sewer connecting No.
Street and hereby agrees to comply with the Rules and Regulations governing the construction and use of Particular
Sewers, as now or at any future time established by the Board of Selectmen.

Am't of estimate \$.....

Am't Paid \$.....

..... Owner

Sketch of Service Here

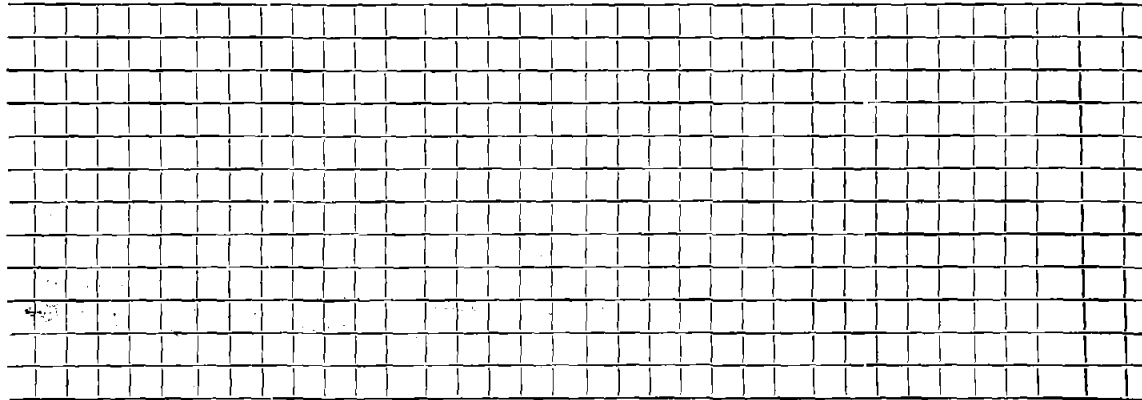

Connection made in Street.

Work completed 19..

Remarks: