

Name Warren Coward

Service No. 46

Address 219 Follen Road

Location

Kind of Pipe

Size

Size of Main

~~Repair~~ ~~Network~~ — New Service W.O.#7936

Location *Comm 8-26-63*


Date	Material	Amount	Total	Date	Amount
5-24-63	Labor 99.99			5-15-63	350.00
5-27-63	" 50.45	150.44		8-26-63	3.30
	10% O.H.	15.04	165.48		346.70
	83' 6" Transite pipe @.88		73.04		
	1 90° Transite Elbow		4.09		
	1 22½° Transite Bend		4.09		
	4 hrs. Town Shovel @6.50		26.00		
	4 hrs. Trucking @3.00		12.00		
	1 hr. Loader @4.00		4.00		
	28 x 3 Patch		28.00		
	10 yds. Loam @3.00		30.00		
			<u>346.70</u>		

DATE _____

TOWN OF LEXINGTON — BOARD OF PUBLIC WORKS

SEWER DIVISION

Sketch of Service Here **219**

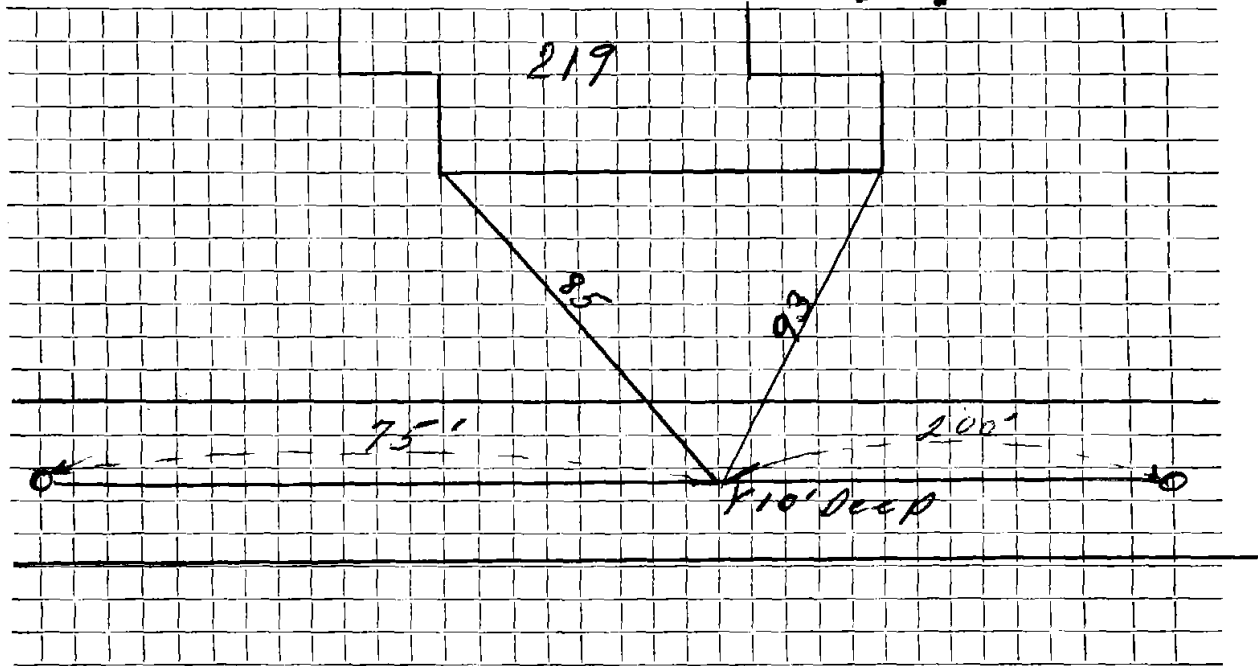

Connection made in Street. Work completed

Remarks:
.....
.....