

Name

Service No.

Joseph Hansen

Address

221 Follen Road

Location

Kind of Pipe

Size

Size of Main

~~Repair/Remove~~

New Service

McKee #4290

Location

Date

Material

Amount

Total

Date

Amount

6/10/86

78'

6" PVC

4

22° Bend

1

Sweep

1

Wye C.O.

1

6" Elbow 90°

1

4" x 6" Donut


DATE \_\_\_\_\_

TOWN OF LEXINGTON — BOARD OF PUBLIC WORKS

SEWER DIVISION

Sketch of Service Here

221

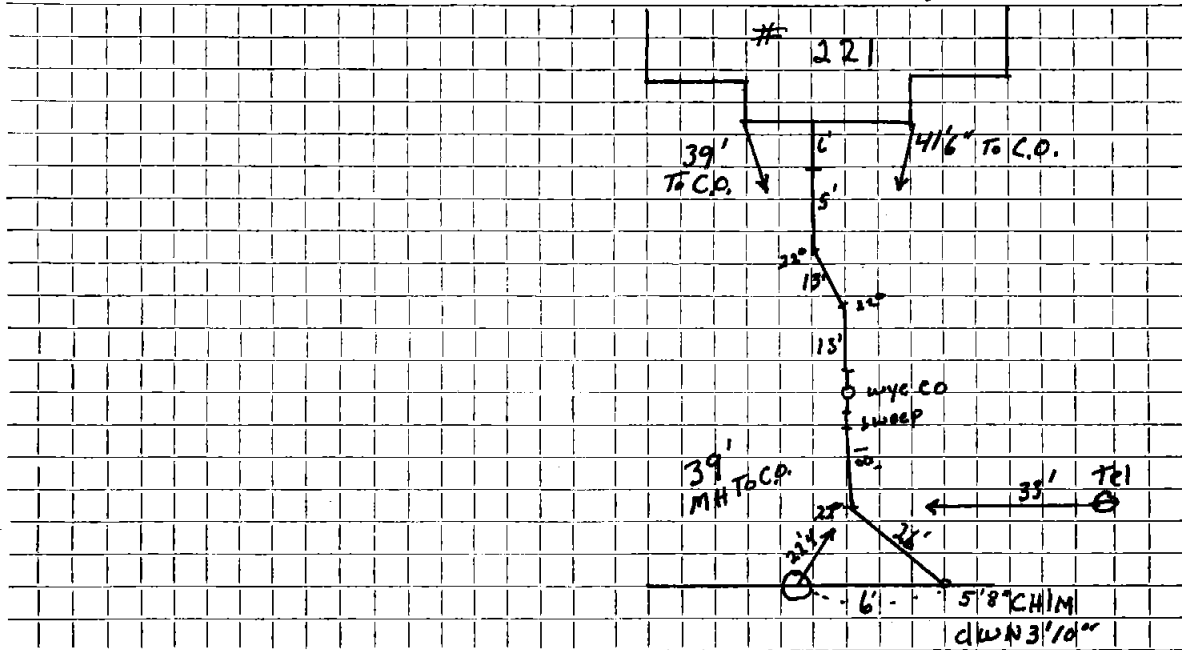

Connection made in *Follen R.D.* ..... Street. Work completed .....

Remarks: .....

.....

.....