

Name John H. Carruthers

Service No. 9

Address 225 Foilen Rd. Lexington

Location

Kind of Pipe

Size

Size of Main

~~Repair/General~~ - New Service WO #4168 Lex-Sewage #2943

Location AUG 16 1976


Date	Material	Amount	Total	Date	Amount
4/2/76	labor	106.96		3/24/76	Deposit 200.00
4/27/76	labor	25.24	132.20	11-1-76	paid 128.75
	10%OH	13.22	145.42		263.15
2	5' X 6" pipe @ 1.56		15.60		
1	10' X 6" pipe @ 1.48		14.80		
1	6" X 8" saddle		14.70		
1	6" X 2' nipple		5.39		
1	6" X 6" elbow		5.48		
1	ton cold patch		13.70		
1	5' X 14' patch		48.00		
1	patch 8 X 16		84.00		
2	hr. truck @ 3.00		6.00		
2	hr. back hoe @ 6.50		13.00		
1/2	comp. @ 5.00		2.50		
			308.75		
4/6/76	52' 6" Transite Pipe				

DATE _____

TOWN OF LEXINGTON — BOARD OF PUBLIC WORKS
SEWER DIVISION

Sketch of Service Here

225

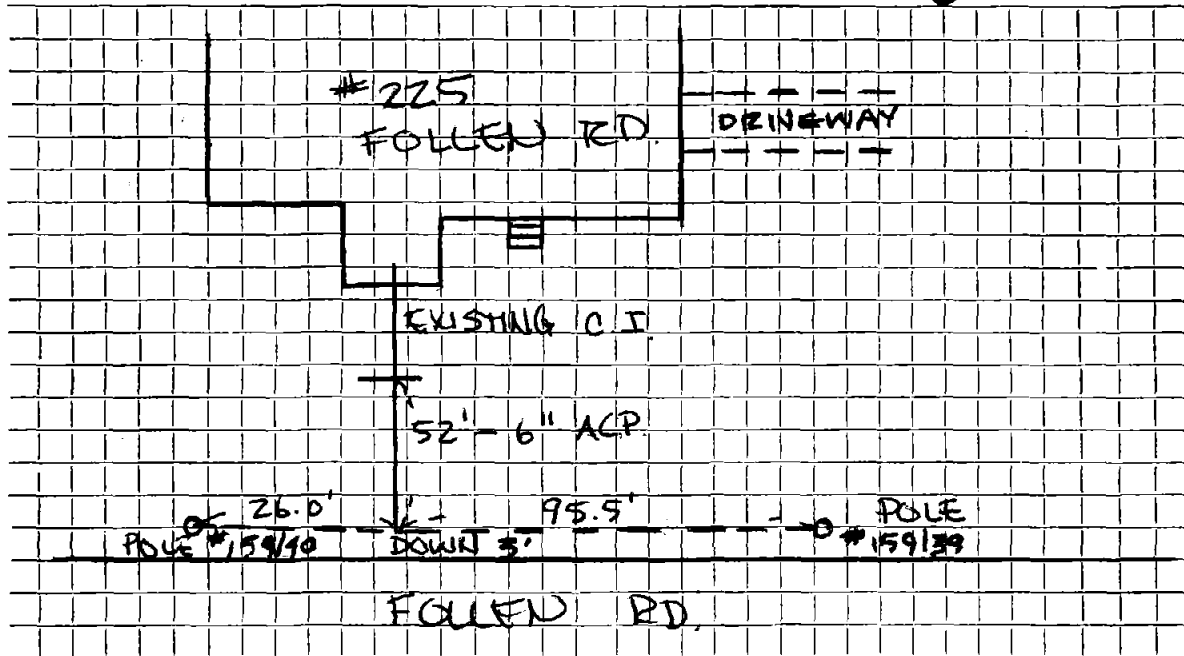

Connection made in FOLLEN RD Street. Work completed 4-6-76

Remarks:

.....
.....