

Name L. M. Burgess

Service No. 60

Address 227 Follen Road

Location

Kind of Pipe

Size

Size of Main

~~Repair~~ ~~Renewal~~ — New Service

com. 8-15-55

Location

Date	Material	Amount	Total	Date	Amount
6/2/55	Labor	110 97		4-26-55	250 00
6/3/55	"	31 04	142 01	8-15-55	16 01
	10% overhead		14 20		233 99
	56' - 6" sewer pipe @ .32		17 92		
	joint compound		3 36		
	5 1/3 hrs. Littlefield shovel @ 7.50		40 00		
	2 hrs. trucking @ .75		1 50		
	patching 15 x 3		15 00		
6-7-90	Repair		233 99		
	9.5' 6" P.V.C.				
	1 6" X 4" Fernco				
	Labor				
	1 6" X 6" Fernco				

TOWN OF LEXINGTON—DEPT. OF PUBLIC WORKS
SEWER DIVISION

DATE

NO.


The undersigned applies for the construction of a particular sewer connecting No.
Street and hereby agrees to comply with the Rules and Regulations governing the construction and use of Particular
Sewers, as now or at any future time established by the Board of Selectmen.

Am't of estimate \$.

Am't Paid \$.

..... Owner

Sketch of Service Here **227**

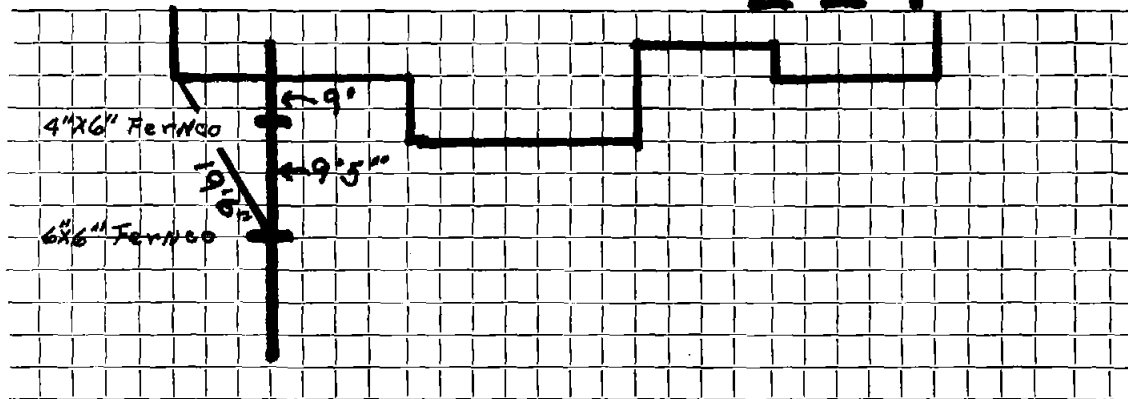

Connection made in Street.

Work completed 19..

Remarks: