

Name R. G. Finnerty

Service No. 148

Address 229 Follen Road

Lexington, Mass.

Location

Kind of Pipe

Size

Size of Main

~~Repair/Removal~~ **New Service**

com. 12-31-51

Location

Date	Material	Amount	Total	Date	Amount
11/19/51	Labor	29 88		10-3-51	Deposited 200 00
	10% overhead	2 99	32 87	12-31-51	Refunded (89 42)
	58' - 6" sewer pipe @ .342		19 83		110 56
	1 - 6" elbow		1 88		
	joint compound		3 48		
	5 hrs. Littlefield shovel @ 7.00		35 00		
	2 hrs. trucking		1 50		
	patching 16 x 3		16 00		
			110 56		
	<b>Labor</b>				

TOWN OF LEXINGTON—DEPT. OF PUBLIC WORKS  
**SEWER DIVISION**

DATE .....

NO. ....

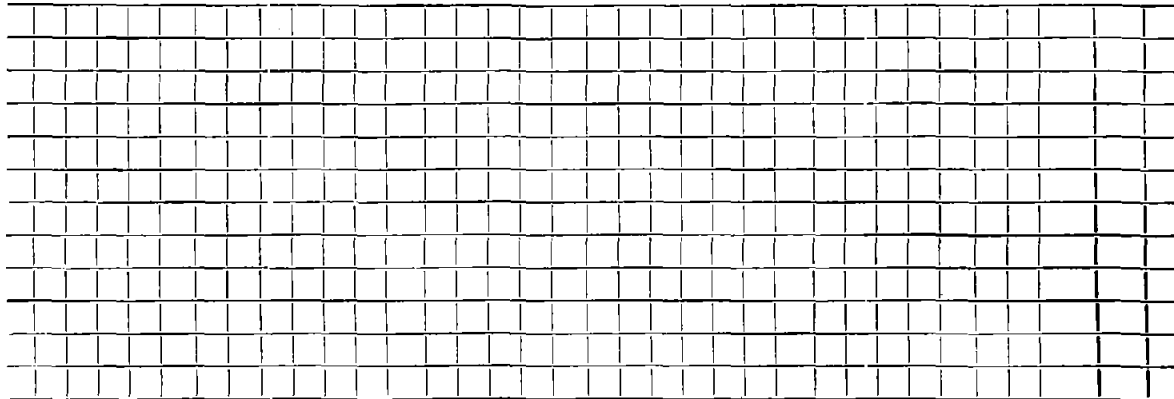
The undersigned applies for the construction of a particular sewer connecting No. ....  
Street and hereby agrees to comply with the Rules and Regulations governing the construction **and** use of Particular  
Sewers, as now or at any future time established by the Board of Selectmen.

Am't of estimate \$.....

Am't Paid \$.....

..... Owner

**Sketch of Service Here**

A large grid of graph paper for sketching service details. The grid consists of 20 columns and 15 rows of small squares, providing a space for drawing or sketching the sewer service layout.

Connection made in ..... Street.

Work completed . . . . . 19..

Remarks: