

Name

Service No.

Address 1 ~~Padpole Lane~~

236 ~~Follen Road~~ (Chgd. per ENG-11-21-67) Location

Kind of Pipe

Size

Size of Main

Repair—Renewal—New Service

Dave Eagle #703

Location

Date		Material	Amount		Total		Date		Amount
8-29-67	42'	6" Transite pipe							
	10'	4" Cast Iron pipe							
							4/23/71	Delis	


DATE \_\_\_\_\_

TOWN OF LEXINGTON — BOARD OF PUBLIC WORKS

SEWER DIVISION

Sketch of Service Here

**236**

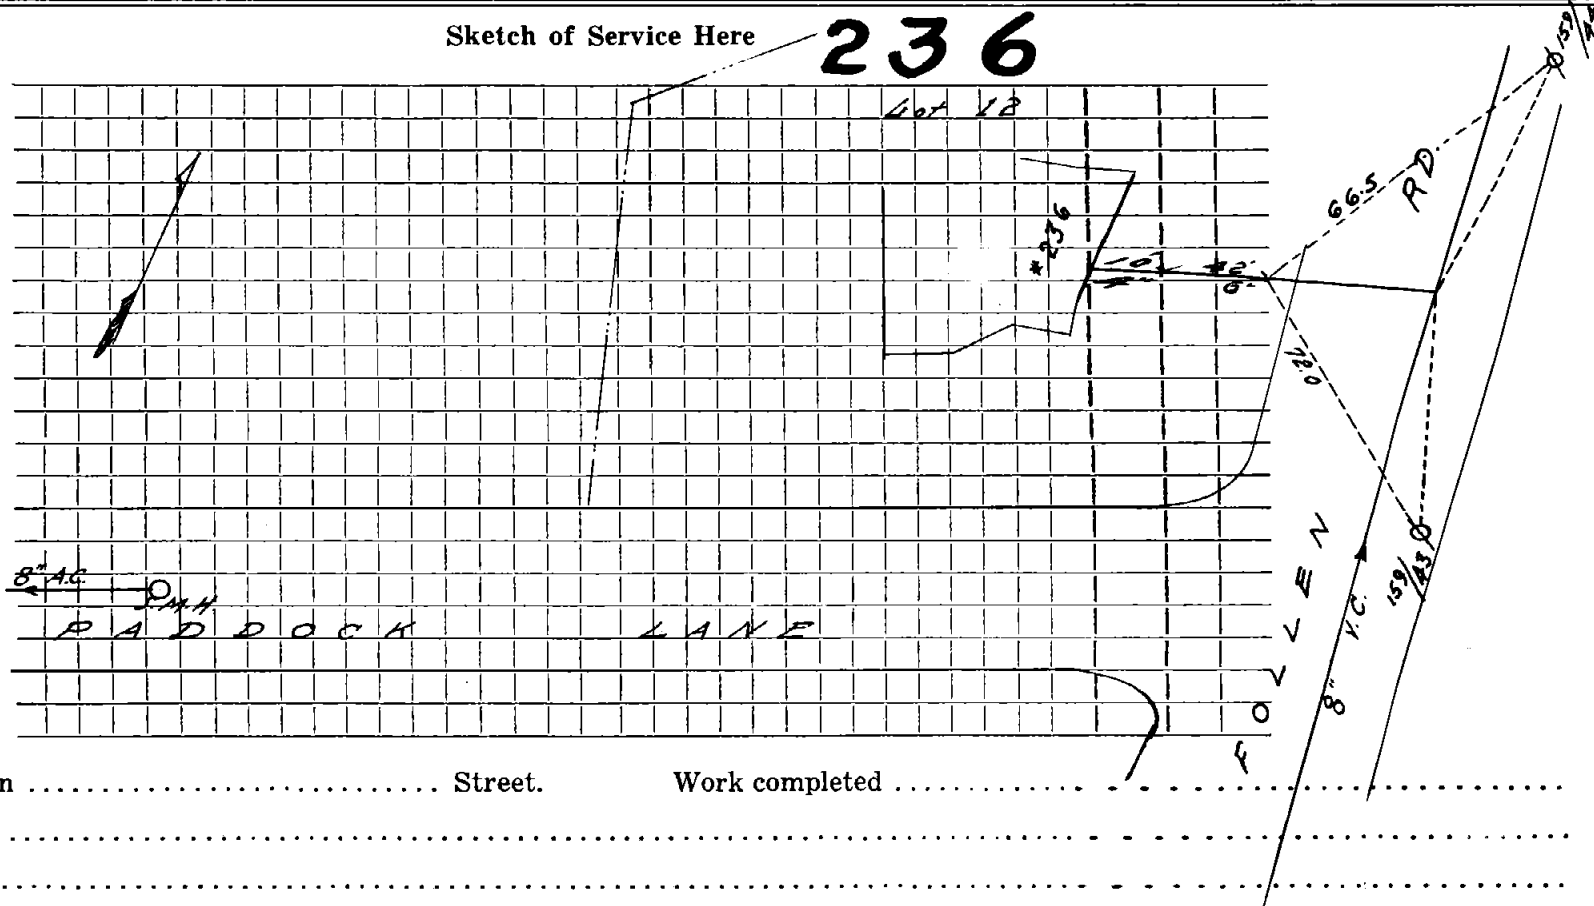

Connection made in ..... Street. Work completed .....

Remarks: .....  
.....  
.....