

Name Angus McIver

Service No. 35

Address 30. Follen Road

Location

Comm. 6-10-57

Kind of Pipe

Size

Size of Main

~~Repair/Reconnect~~—New Service

Location

Date	Material	Amount	Total	Date		Amount
5/10/57	Labor	56 01		4-8-57	Deposit	\$ 200 00
5/11/57	Labor	23 62		6-10-57	Refund	5 71 80
	10% overhead	7 96	87 59			\$ 178 20
	60' 6" Transite @.7020		42 12			
	10' 6" V.C. Sewer Pipe @.435		4 35			
	Joint Compound		60			
	1 6" Bend Transite		2 79			
	4 ½ Hrs. Town Shovel @6.50		29.25			
	2 Hrs. trucking @.75		1 50			
	Patching		10 00			
			178 20			
	Labor					

TOWN OF LEXINGTON—DEPT. OF PUBLIC WORKS

SEWER DIVISION

DATE

NO.


The undersigned applies for the construction of a particular sewer connecting No. Street and hereby agrees to comply with the Rules and Regulations governing the construction and use of Particular Sewers, as now or at any future time established by the Board of Selectmen.

Am't of estimate \$.....

Am't Paid \$.....

..... Owner

Sketch of Service Here

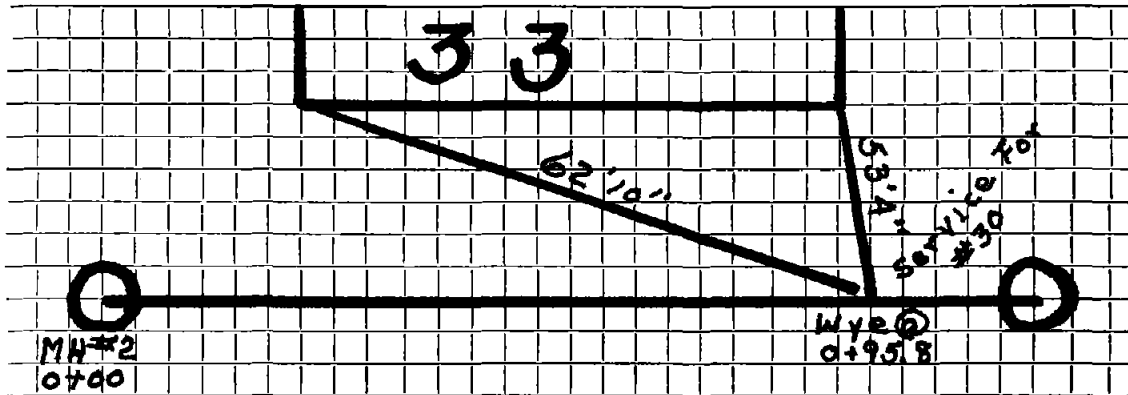

Connection made in Street.

Work completed 19..

Remarks: