

Name Richard McArdle

Service No. 23

Address 33 Follen Road

Location

Comm. 6-10-57

Kind of Pipe

Size

Size of Main

Repair—Renewal—New Service

Location

Date	Material	Amount	Total	Date	Amount
4/12/57	Labor	35 44		3-25-57	Deposit
4/13/57	"	84 96		6-10-57	Refund
		120 40			NON CHARGE
	10% overhead	12 04	132 44	4/11/57	Labor
	92' Transite Pipe @ .7020		64 58	4/13/57	"
	6' - 6" V.C. Sewer pipe @ .435		2 61	4/15/57	"
	Joint compound		36	4/24/57	"
	1 - 6" Bend		1 88	4/25/57	"
	7 hrs. Town Shovel @ 6.50		45 50	4/26/57	"
	8 hrs. Trucking @ .75		6 00		
	1 hr. Compressor		3 00	2 hrs. Town Shovel @ 6.50	
	8 hrs Labor Jager Pump @ 1.00		8 00	2 hrs. Trucking @ .75	
			264 37		
				11/8/71	Photo
				11/6/64	Sludge
				5/13/65	PIPE DOESN'T MEET MAIN

TOWN OF LEXINGTON—DEPT. OF PUBLIC WORKS

SEWER DIVISION

DATE

NO.


The undersigned applies for the construction of a particular sewer connecting No. Street and hereby agrees to comply with the Rules and Regulations governing the construction and use of Particular Sewers, as now or at any future time established by the Board of Selectmen.

Am't of estimate \$.....

Am't Paid \$.....

..... Owner

Sketch of Service Here 33

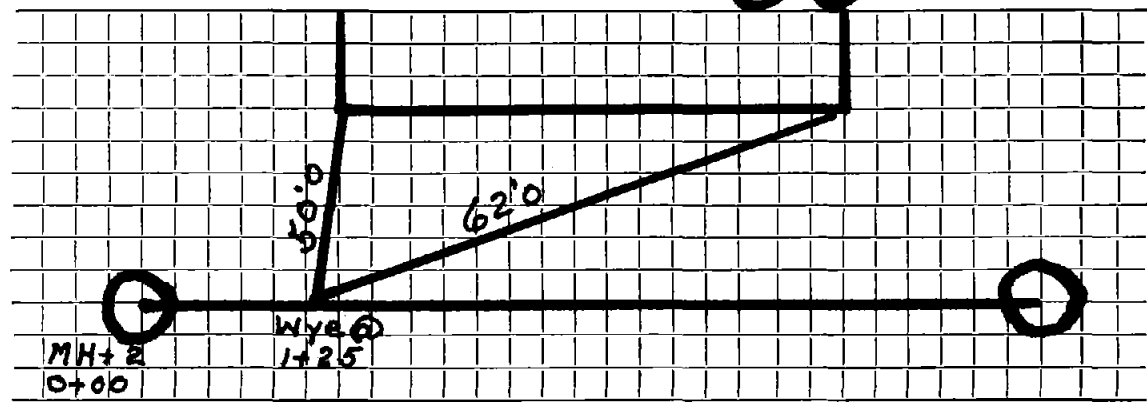

Connection made in Street.

Work completed 19..

Remarks: