

Name

Service No.

Address 40 Follen Road

Lot #26

Location

Kind of Pipe

Size

Size of Main

Repair—Renewal— New Service

Location

Date

Material

Amount

Total


Date

Amount

DATE _____

TOWN OF LEXINGTON — BOARD OF PUBLIC WORKS
SEWER DIVISION

Sketch of Service Here

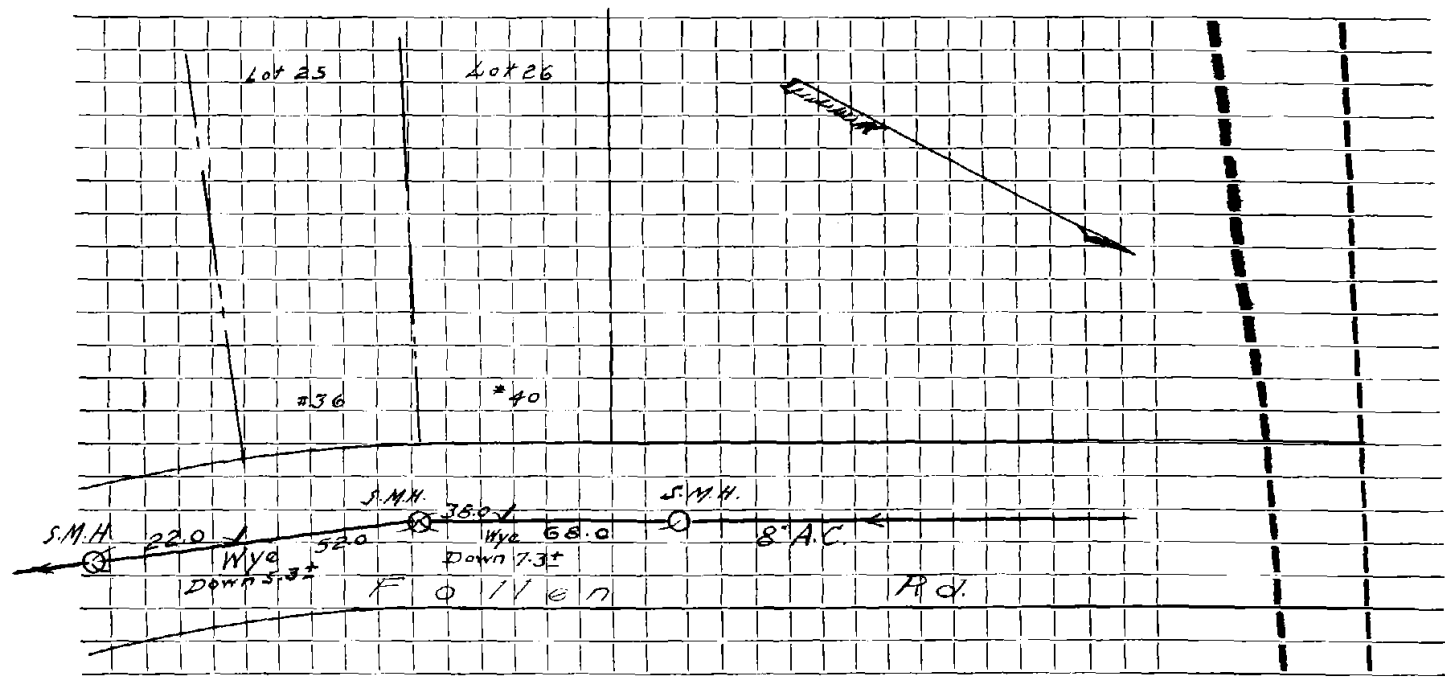

Connection made in Street. Work completed

Remarks:

.....

.....