


DATE _____

TOWN OF LEXINGTON — BOARD OF PUBLIC WORKS

SEWER DIVISION

Sketch of Service Here

43

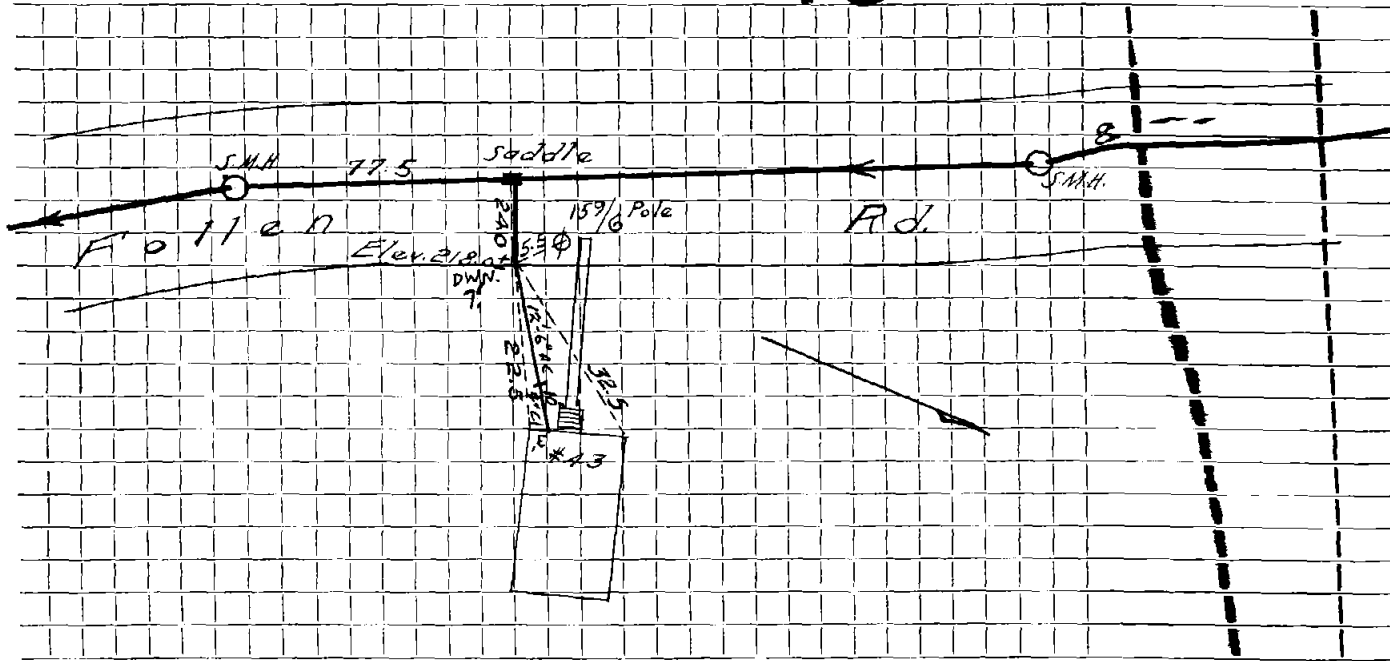

Connection made in FOLLEN RD. Street. Work completed _____

Remarks: _____
