


DATE 1965

TOWN OF LEXINGTON — BOARD OF PUBLIC WORKS
SEWER DIVISION

Sketch of Service Here

52

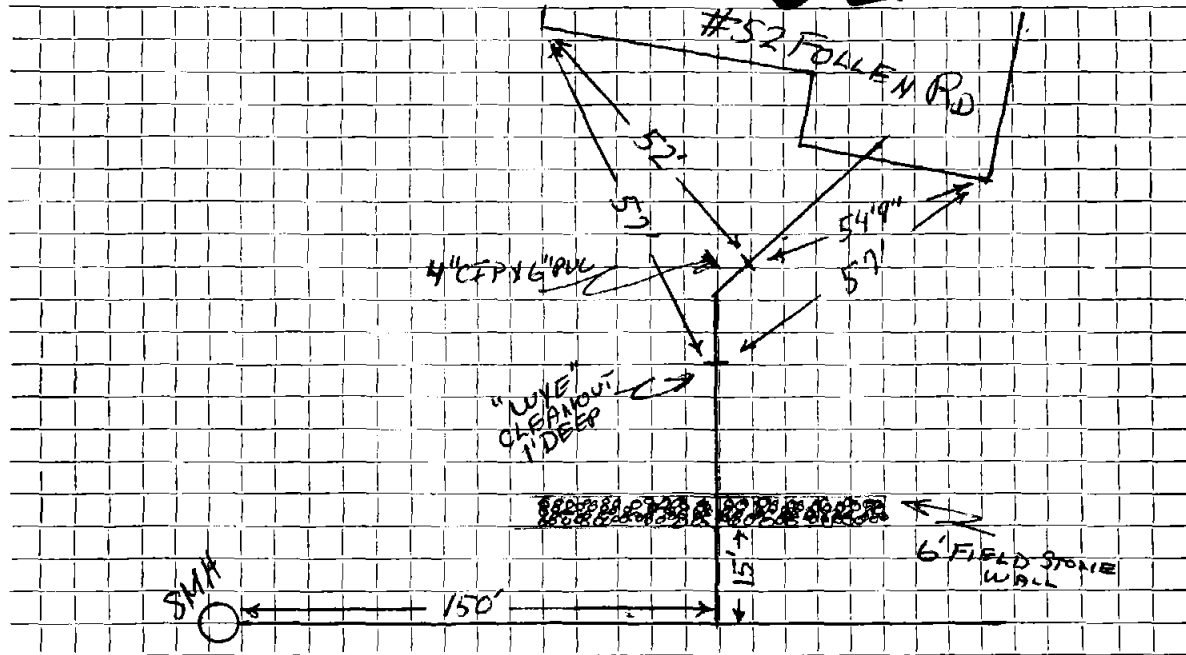

Connection made in FOLLEN RD Street. Work completed JUNE 7, 1983

Remarks:

.....

.....