

Name

Service No.

Address 99 FOLLEN RD

Location

Kind of Pipe PVC

Size 6" SERVICE

Size of Main 8"

Repair—Renewal—New Service CONTRACT 99-12 / FIORE CONSTRUCTION

Location

Date	Material	Amount	Total	Date		Amount
------	----------	--------	-------	------	--	--------


5-16-2000

37' 6" PVC LATERAL \$1,110 00

DATE 5-16-2000

TOWN OF LEXINGTON — BOARD OF PUBLIC WORKS
SEWER DIVISION

Sketch of Service Here

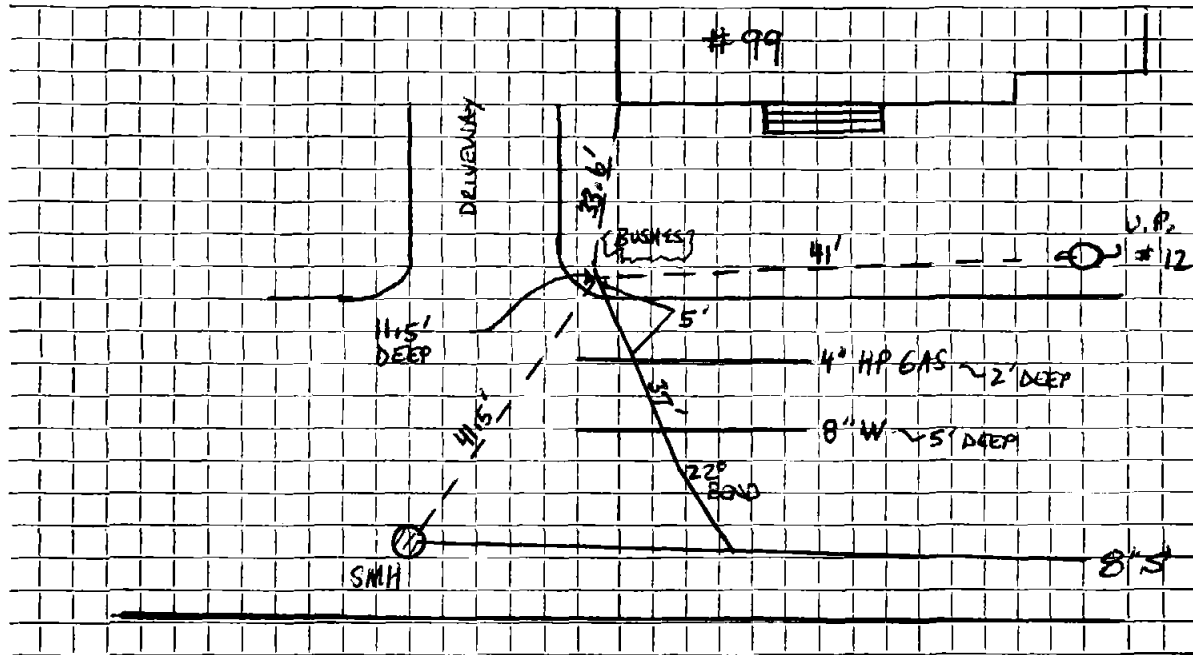

Connection made in Street. Work completed

Remarks: 37' OF 6" PVC IN PLACE (20' TO 22° BEND + 17' TO PROPERTY LINE) / SERVICE 18.5' DOWN FROM GRADE...
5' BTW END OF SEWER SERVICE TO GAS MAIN

FIELD BOOK 99-12-2 P640