




DATE 5-15-2000

TOWN OF LEXINGTON — BOARD OF PUBLIC WORKS  
SEWER DIVISION

Sketch of Service Here

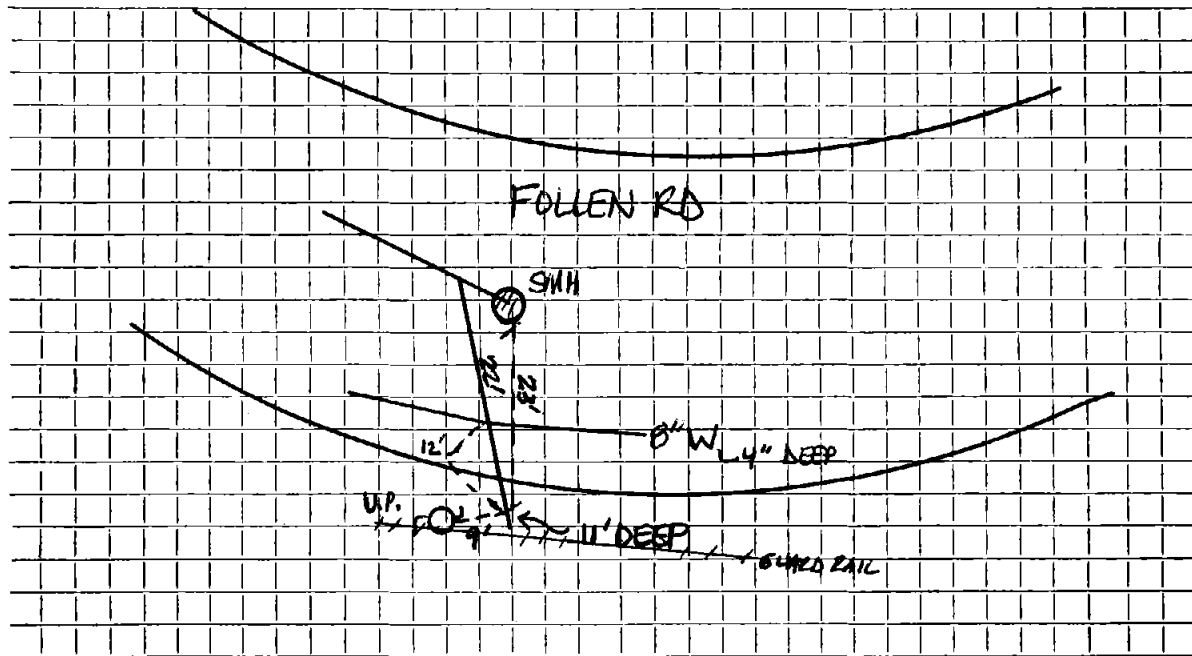

Connection made in ... FOLLEN ... Street. Work completed .....

Remarks: .. 6" SEWER SERVICE CROSSES ~ 6' BELOW WATER MAIN .....

.. 6" SERVICE END 11' DOWN FROM GRADE .....

.. LEDGE REMOVED TO PLACE SERVICE .....

FIELD BOOK 99-12-2  
PAGE 39 D.F.