

Name

Service No.

Address FOLLEN RD (VACANT LOT, MAP 22/LOT 127)

Location

Kind of Pipe PVC

Size

Size of Main 8"

Repair—Renewal—New Service

CONTRACT 99-12 : FIDRE CONSTRUCTION

Location

Date	Material	Amount	Total	Date	Amount
------	----------	--------	-------	------	--------

5-12-2000


21' 6" PVC LATERAL

\$ 630.00

DATE 5-12-2000

TOWN OF LEXINGTON — BOARD OF PUBLIC WORKS
SEWER DIVISION

Sketch of Service Here

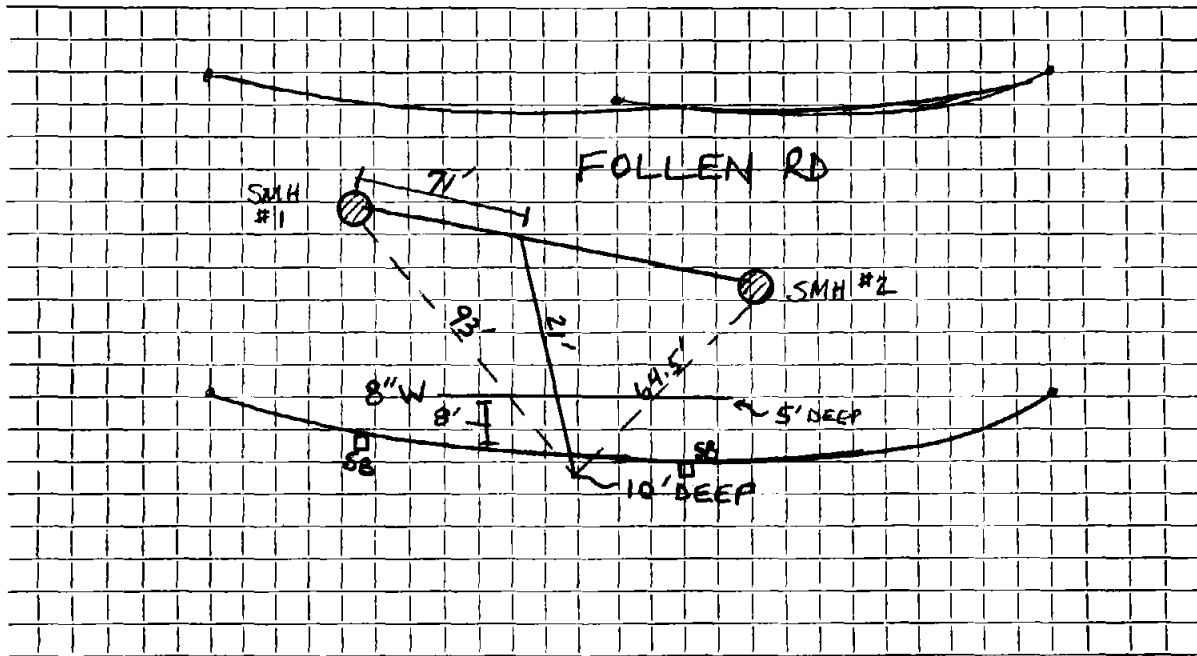

Connection made in .. FOLLEN .. Street. Work completed

Remarks: 6" SERVICE CROSSES UNDER 8" WATER MAIN ~ 5'

6" SERVICE ~ 10' DEEP FROM PAVEMENT

LEDGE REMOVED TO PLACE SERVICE

FIELD BOOK 99-12-2
PAGE 38 D.F.