

Name Honeywell Mfg. Co.

Service No.

Address 2 Forbes Road

Location

Kind of Pipe

Size

Size of Main

Repair—Renewal—New Service


Location

Date		Material	Amount		Total		Date		Amount	
1967										

DATE _____

TOWN OF LEXINGTON — BOARD OF PUBLIC WORKS
SEWER DIVISION

Sketch of Service Here

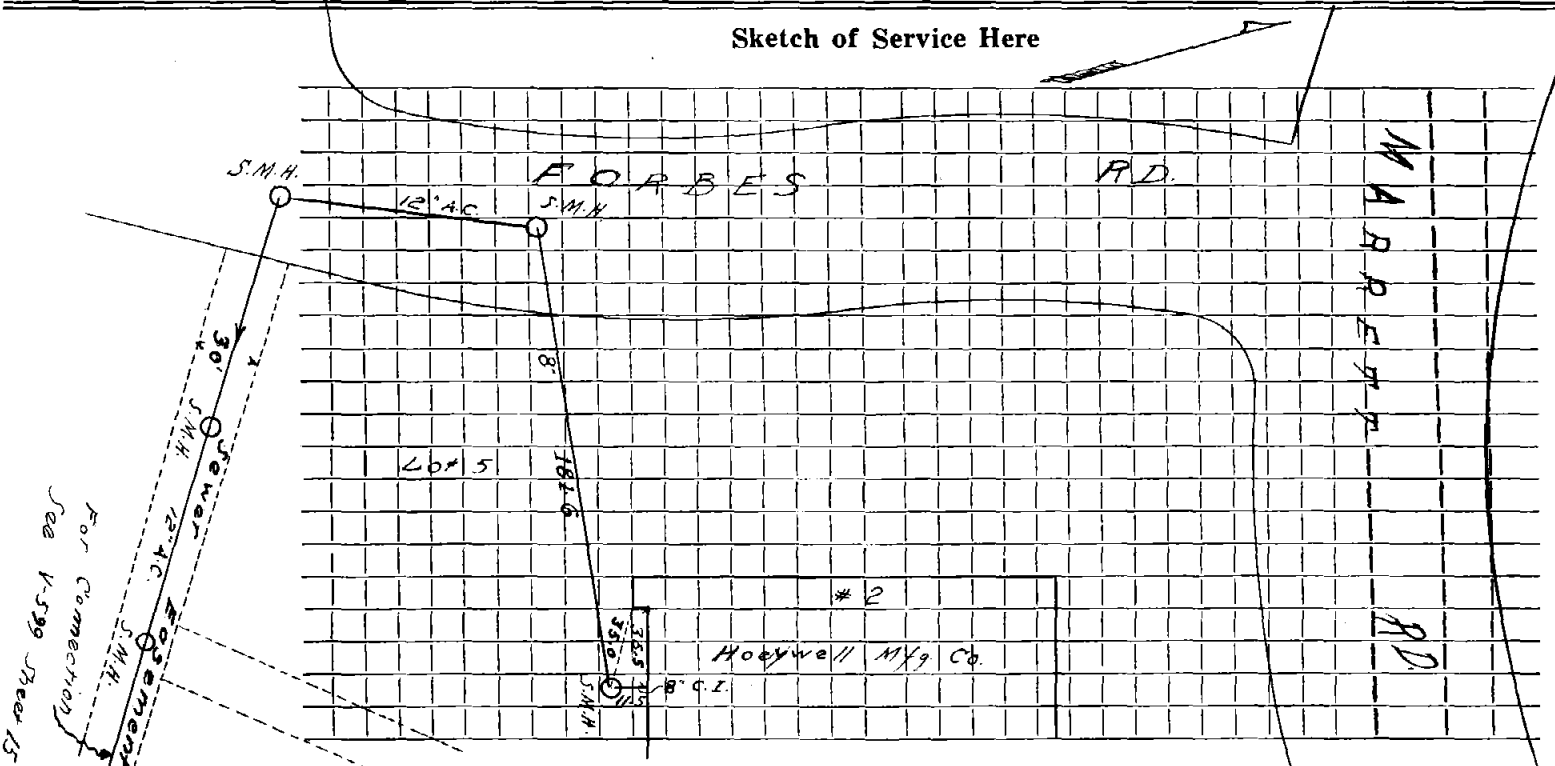

Connection made in Street. Work completed

Remarks:

.....

.....