

Name

Service No.

Address

5-7 Forest Court

Location

Kind of Pipe

Size

Size of Main

Repair—Renewal—New Service

Location

Date

Material

Amount

Total

Date

Amount

11.0 -

Outside
6" PVC
1-6" CI-PVC
Fenaco

8-17-93


Roofs At Main

DATE _____

TOWN OF LEXINGTON — BOARD OF PUBLIC WORKS

SEWER DIVISION

Sketch of Service Here

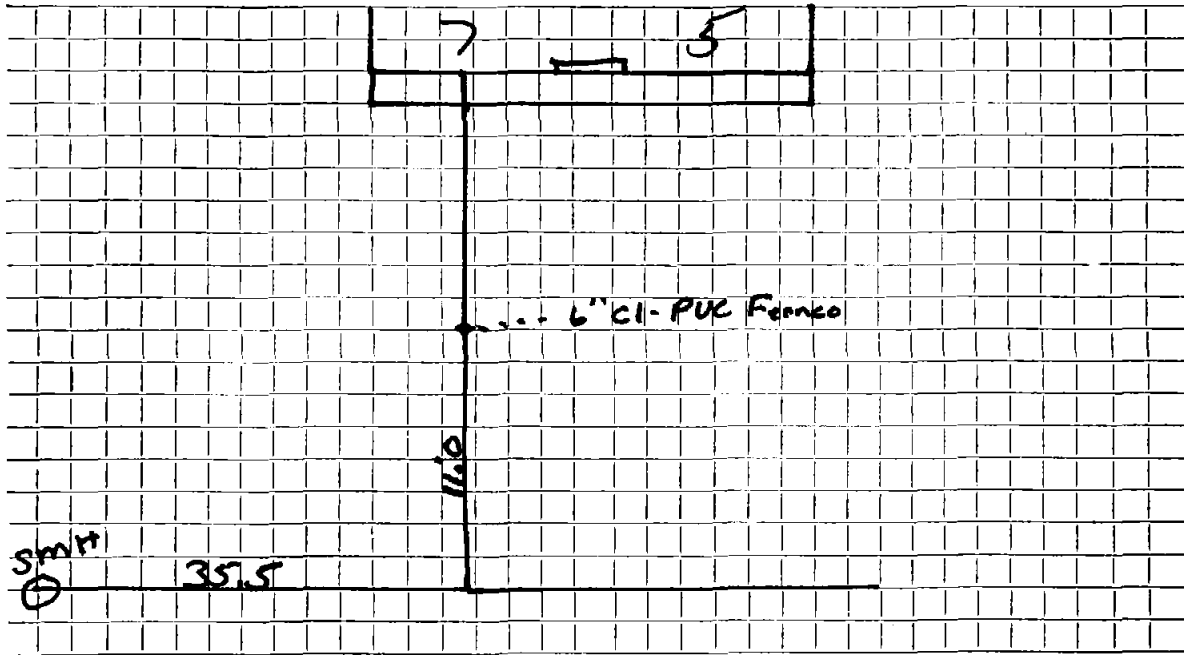

Connection made in Street. Work completed

Remarks:

.....

.....