


DATE MAY 25, 1984

TOWN OF LEXINGTON — BOARD OF PUBLIC WORKS
SEWER DIVISION

Sketch of Service Here

12

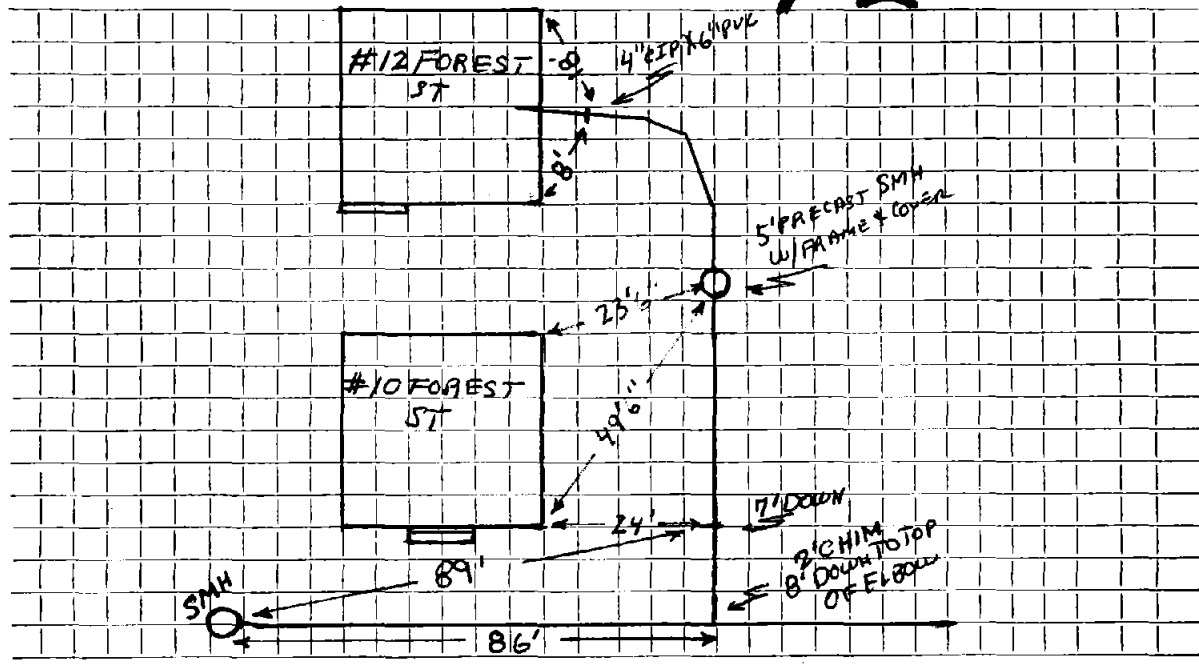

Connection made in FOREST ST Street. Work completed MAY 30, 1984

Remarks:

.....

.....