

Name Christian Science Church

Service No. 9 1022

Address Forest Street 14-16

Lexington, Mass.

Location Forest St.

Kind of Pipe

Size

Size of Main

~~Repair~~ ~~Renew~~ ~~XXXX~~ New Service

Location

Date	Material	Amount	Total	Date	Amount
May 21, '46	Labor	47 73		May 8 '46	123 00
22	"	37 18		Feb. 3 '47	2 10
23	"	<u>31 92</u>	116 83		122 10
	10% Overhead		11 68	2-15-52	Repair
	62' - 6" Sewer Pipe @ .256		15 87		10' 6" Sewer Pipe
	10' - 4" Soil Pipe @ .50		5 00		2 6" Elbows
	Joint Compound		3 72		
	Patching 15 x 4		20 00		
	Compressor 1hr @ 1.75		1 75		
	Trucking 3 hrs. @ .75		<u>2 25</u>		
			177 10		
7-15-55	Labor New Service				
	125' 6" Sewer Pipe				

TOWN OF LEXINGTON—DEPT. OF PUBLIC WORKS

SEWER DIVISION

DATE

NO.


The undersigned applies for the construction of a particular sewer connecting No.
Street and hereby agrees to comply with the Rules and Regulations governing the construction and use of Particular
Sewers, as now or at any future time established by the Board of Selectmen.

Am't of estimate \$.....

Am't Paid \$.....

..... Owner

Sketch of Service Here

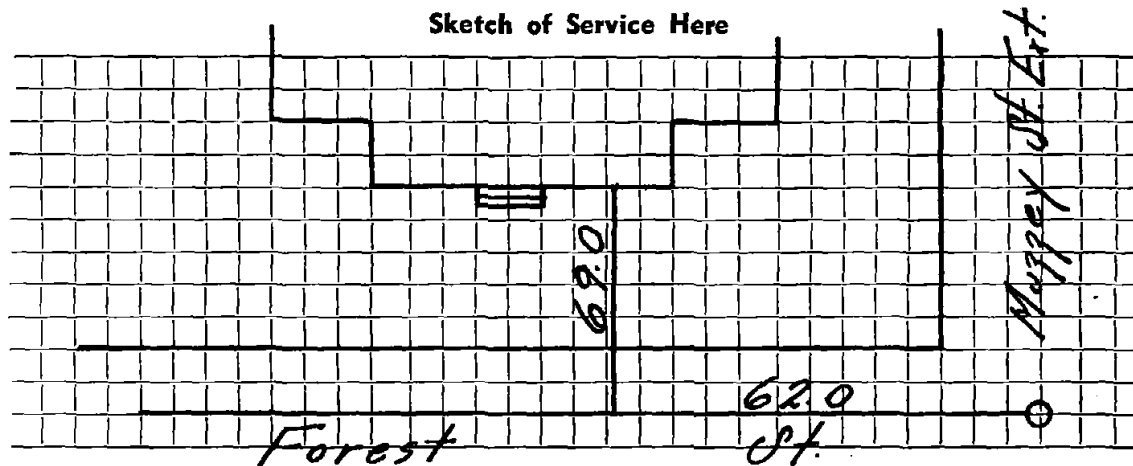

Connection made in Street.

Work completed 19..

Remarks: