


DATE _____

TOWN OF LEXINGTON — BOARD OF PUBLIC WORKS

SEWER DIVISION

Sketch of Service Here
#19 FOREST ST.

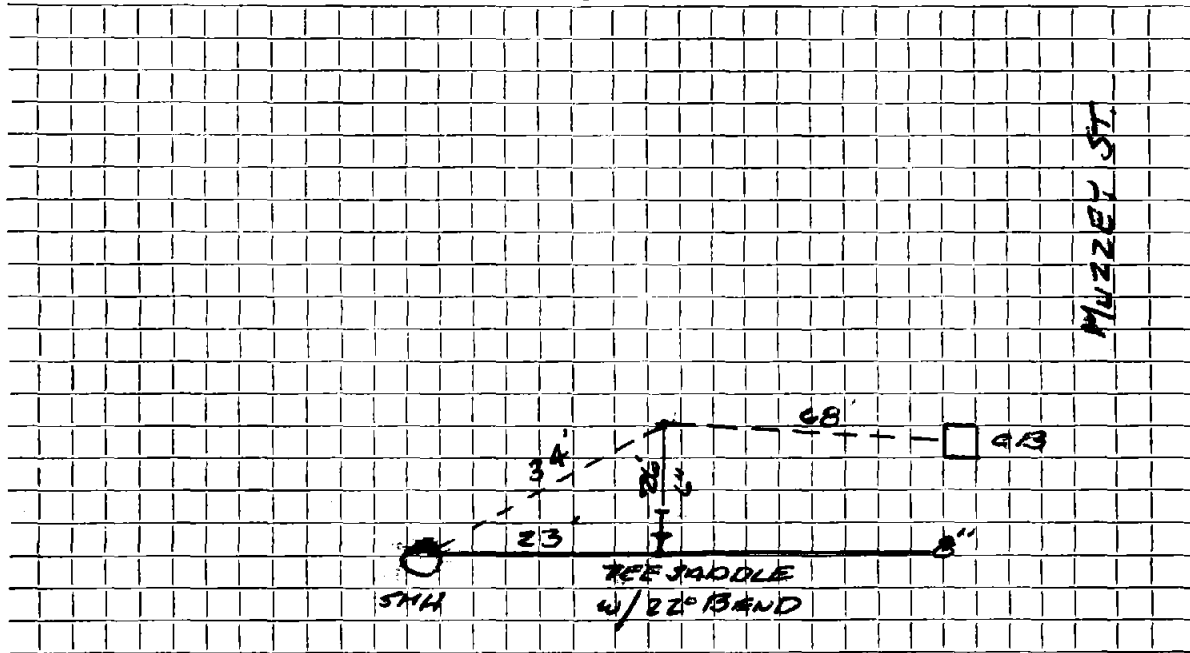

Connection made in FOREST ST. Street. Work completed

Remarks: Original card 1932