

Name Theresa F. Ellis

(Paid by W. G. Black)

Service No. 11

244

Address 2 Forest Street

Location

Kind of Pipe

Size

Size of Main

Repair—Renewal—New Service

Location

Date
1941

Material

Amount

Total

Date

Amount

June 20,

8 hrs. @ 50¢

4 00

June 7, 1941

Deposited

50 00

24 1/2 " @ 60¢

14 70

18 70

September 16, 1941

Refunded

5 78

10% Overhead

1 87

44 22

48' 6" Sewer Pipe @ 16¢

7 68

Jointing compound

2 88

1 hr. compressor @ 2.25

2 25

2 hrs. trucking @ 75¢

1 50

Trench repairs

9 34

44 22

Labor

TOWN OF LEXINGTON—BOARD OF PUBLIC WORKS
SEWER DIVISION

DATE 6/7 41


NO. _____

The undersigned applies for the construction of a particular sewer connecting No. 2 Forest St Street and hereby agrees to comply with the Rules and Regulations governing the construction and use of Particular Sewers, as now or at any future time established by the Board of Selectmen.

Am't. of Estimate \$ 50⁰⁰

Am't. Paid \$ 50⁰⁰

Theresa F. Ellis Owner

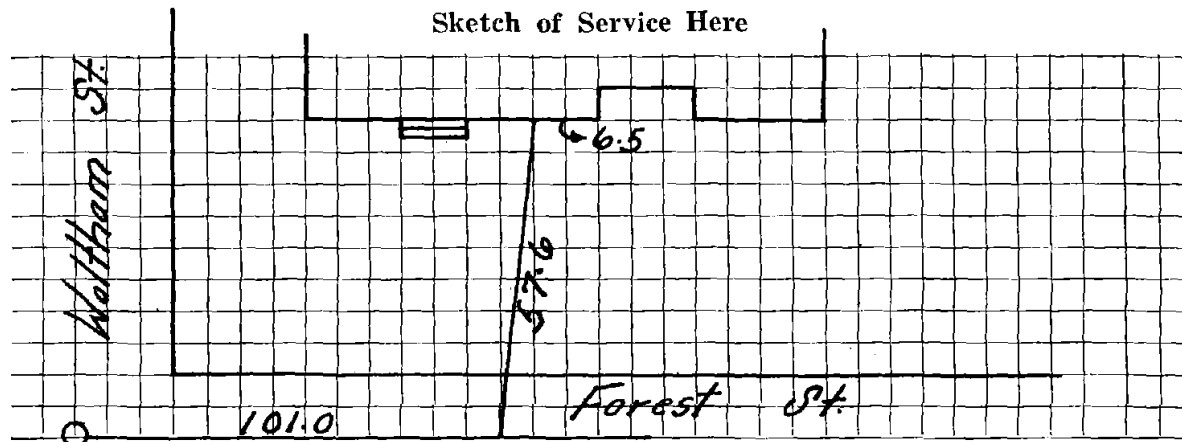

Connection made in _____ Street.

Work completed _____ 19

Remarks: