

Name Dr. M. D. Straw

Service No. 14 256

Address ²⁵¹ Forest St.

Location

Kind of Pipe

Size

Size of Main

~~Repair~~ ~~Renewal~~ New Service

Location

Date	Material	Amount	Total	Date	Amount
6/28/33 <i>9-19-33 for</i>	48' 6" Sewer Pipe @.15	7 20		<i>June 23 1933 - Cash</i>	65 -
	Sulphur & Jute	1 92			
	Trucking-4 Hrs. @.75	3 00	12 12		
	84 Hrs. Labor @.50	42 00			
	20 " " @.55	11 00	53 00		
	15% Overhead		7 95		
<u>COST</u>			\$73 07		
<u>CHARGE</u>	Estimated cost,	\$65 00	\$65 00		
	Labor				

Hadley Press, Inc., Lexington

TOWN OF LEXINGTON—BOARD OF PUBLIC WORKS
SEWER DIVISION

DATE _____

NO. _____


The undersigned applies for the construction of a particular sewer connecting No. _____ Street and hereby agrees to comply with the Rules and Regulations governing the construction and use of Particular Sewers, as now or at any future time established by the Board of Selectmen.

Am't. of Estimate \$ _____

Am't. Paid \$ _____

Owner

Sketch of Service Here

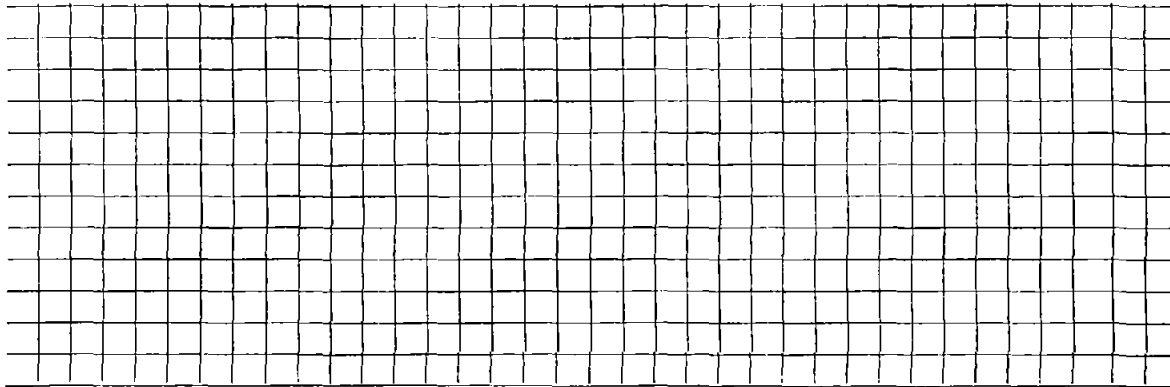

Connection made in _____ Street.

Work completed _____ 19

Remarks: