

Name

Service No. 262

Address

Location 36 Forest Street

Kind of Pipe

Size

Size of Main

Repair—Renewal—New Service

Location

Date

Material

Amount

Total

Date

Amount

1927

Renewed by Redmond Permit #3622

12-9-80 30'

P.V.C. pipe  
(back edge of sidewalk to iron pipe)

4-7-81

10' 6" Transite  
2 6" X 5' Nipples  
1 6" P.V.C. To A.C.  
1 6" X 3' Nipple

Labor

4/7/71 Roots out near sidewalk

# TOWN OF LEXINGTON—BOARD OF PUBLIC WORKS

## SEWER DIVISION

DATE \_\_\_\_\_

NO. \_\_\_\_\_

The undersigned applies for the construction of a particular sewer connecting No. 36 Forest St. Street and hereby agrees to comply with the Rules and Regulations governing the construction and use of Particular Sewers, as now or at any future time established by the Board of Selectmen.


Am't. of Estimate \$ \_\_\_\_\_

Am't. Paid \$ \_\_\_\_\_

Owner \_\_\_\_\_

Sketch of Service Here

36

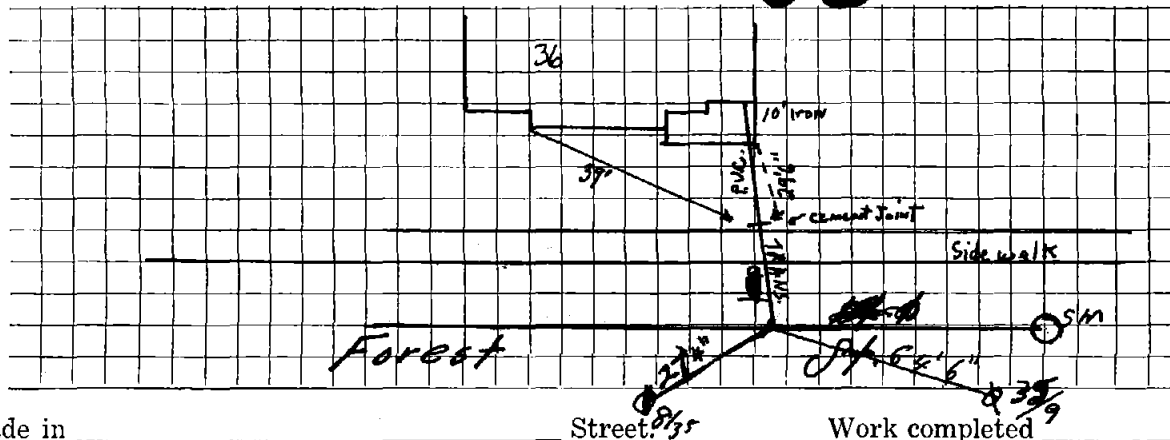

Connection made in \_\_\_\_\_

Street: 8/31/9

Work completed \_\_\_\_\_

19

Remarks: