

Name Helen R. Collins

Service No. 27 265

Address ⁴⁴ 45 Forest Street

Location ⁴⁴ 46 Forest Street

Kind of Pipe

Size

Size of Main
to sewer main
Location

~~Repair - Renewal~~ — New Service Note: Had to dig 15' deep in street

Date	Material	Amount	Total	Date	Amount
Jan 22-28	26' 6" Sewer Pipe @.30	7 80			
	1 6" Ell (1/4" Bend)	70			
	Sulphur & Jute	1 04			
	Trucking	75	10 29		
	<u>Time for sewer and water</u>				
5/3/28	62 Hours Labor @.55	34 10		July 15 1928 - Cash	48 29
	2 " " @.60	1 20	35 30	Aug 7 1928 - Abate	2 60
	15% Overhead		5 30	6-3-83 Renewal	
			50 89	20' 4" P.V.C.	
				1 90° P.V.C. Elbow	
				1 4" X 5" Adapter	
4-16-	82 Repair				
	34' 4" C.I.P.				
	10' 6" P.V.C.				
	1 Labor 4" DONUT (Rubber Chocolate)				

Hadley Press, Inc., Lexington

TOWN OF LEXINGTON—BOARD OF PUBLIC WORKS

SEWER DIVISION

DATE April 23, 1928

NO. 44 Forest Street


The undersigned applies for the construction of a particular sewer connecting No. Forest Street Street and hereby agrees to comply with the Rules and Regulations governing the construction and use of Particular Sewers, as now or at any future time established by the Board of Selectmen.

Am't. of Estimate \$ _____

Am't. Paid \$ _____

Walter P Collins Owner
45 Forest Street

Sketch of Service Here **44**

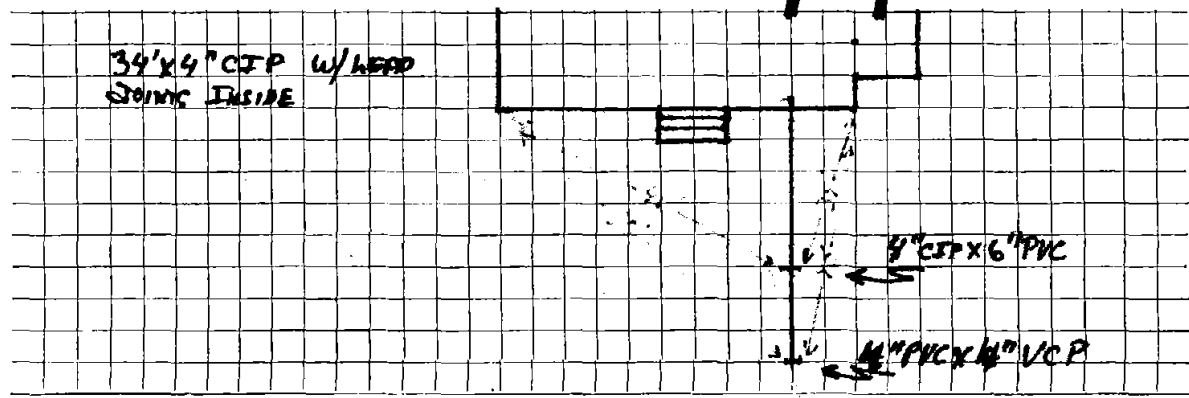

Connection made in FOREST ST Street.

Work completed _____ 19 _____

Remarks: WATER & SEWER IN SAME TRENCH

SEWER MAIN 15' DEEP -