

Name

Service No.

Address

45 Forest Street

Location

Kind of Pipe

Size

Size of Main

Repair—Renewal—New Service

Location

Date	Material	Amount	Total	Date	Amount
6/13/84	5' 6" PVC Pipe				
	1 22½ Transite Elbow				
	1 11½ Transite Elbow				
	1' 6" Transite Nipple				
	1 6" Trans to PVC Adapter				
	1 6" Fernco PVC to Clay Coupling				
				6/13/84	
				5' 6" PVC Pipe	
				1 22½ Trans Elbow	
				1 11½ Trans Elbow	
				1 6" X 1" Trans Nipple	
				1 6" Trans. to PVC Adapter	
				1 6" Fernco PVC to Clay Coupling	


OUTSIDE - W.O. 790

DATE _____

TOWN OF LEXINGTON — BOARD OF PUBLIC WORKS

SEWER DIVISION

Sketch of Service Here

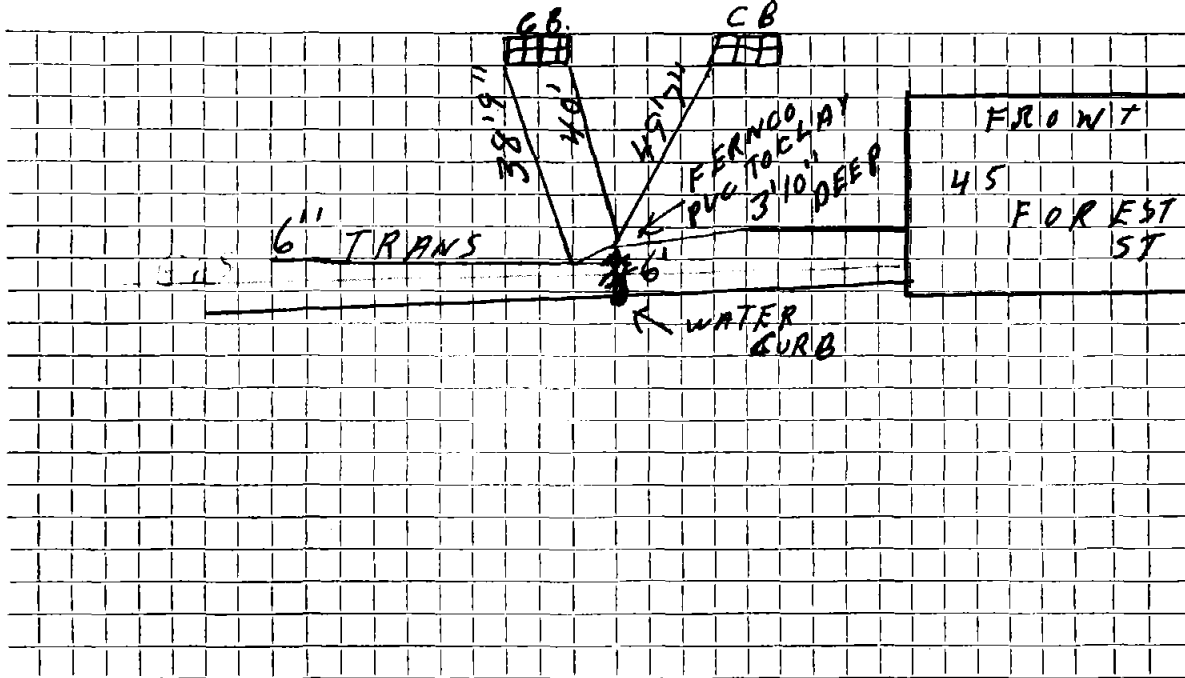

Connection made in Street. Work completed

Remarks: *Original Service 7-23-29*

.....
.....