

Name **Emile Saulnier**

Service No. **60**

Address **46 Forest Street**

Lexington

Location

Kind of Pipe

Size

Size of Main

~~Repair~~ ~~Renewal~~ **New Service**

Com. 11-6-50

Location

Date	Material	Amount		Total		Date	Amount
Aug. 24 '50	Labor	29	37			Aug. 11 '50	150 00
	10% Overhead	2	94	32	21	<i>Deposited</i>	<i>3.74</i>
	56' - 6" Sewer Pipe			15	68		<i>111 56</i>
	1 - 6" Elbow			1	56		
	Joint Compound			3	36		
	6 hrs. Littlefield Shovel			42	00		
	1 hr. Trucking				75		
	Patching 16 x 3			16	00		
				111	56		
	Labor						

TOWN OF LEXINGTON—DEPT. OF PUBLIC WORKS
SEWER DIVISION

DATE

NO.


The undersigned applies for the construction of a particular sewer connecting No.
Street and hereby agrees to comply with the Rules and Regulations governing the construction **and** use of Particular
Sewers, as now or at any future time established by the Board of Selectmen.

Am't of estimate \$.....

Am't Paid \$.....

..... Owner

Sketch of Service Here

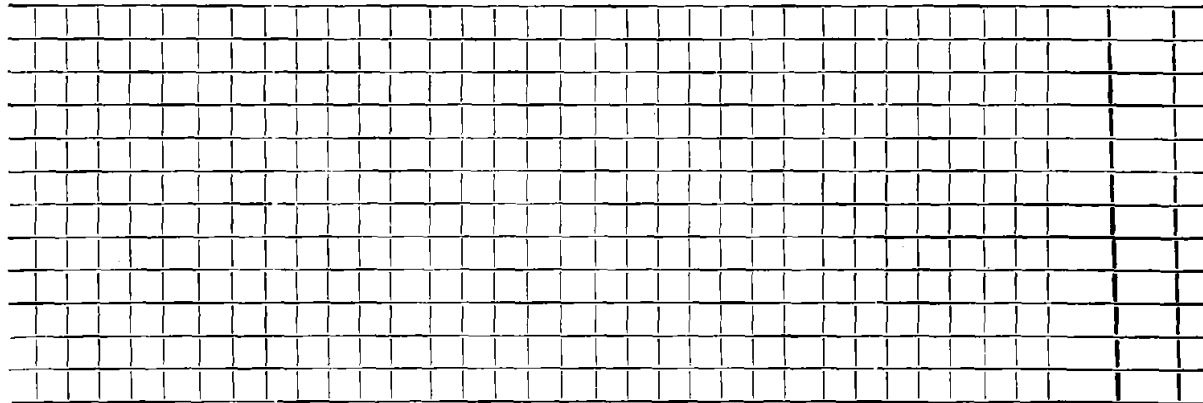

Connection made in Street.

Work completed .. - - 19..

Remarks: